

WATER WELL PLUGGING RECORD

Form WWC-5P

KSA 82a-1212

ID No.


IW-1

1 LOCATION OF WATER WELL: Fraction NE 1/4 NW 1/4 NW 1/4 Section Number 15 Township Number 3S Range Number 19W
 County: Phillips

Distance and direction from nearest town or city street address of well if located within city?
 Main Street, Stuttgart, KS

2 WATER WELL OWNER: Stuttgart Oil Company
 RR#, St. Address, Box #
 City, State, ZIP Code : Stuttgart, KS 67670
 Board of Agriculture, Division of Water Resources
 Application Number:

3 MARK WELL'S LOCATION WITH AN "X" IN SECTION BOX:

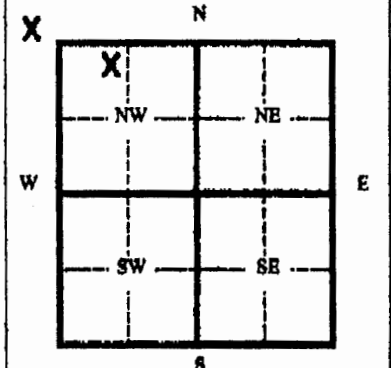

4 DEPTH OF WELL 36 ft.

WELL'S STATIC WATER LEVEL 30 ft.

- WELL WAS USED AS:
- 1 Domestic
 - 2 Irrigation
 - 3 Feedlot
 - 4 Industrial
 - 5 Public Water Supply
 - 6 Oil Field Water Supply
 - 7 Lawn and Garden (domestic)
 - 8 Air Conditioning
 - 9 Dewatering
 - 10 Monitoring Well
 - 11 Injection Well
 - 12 Other

Was a chemical/bacteriological sample submitted to Department? Yes ... No ...
 If yes, mo/day/yr sample was submitted _____
 Water Well Disinfected: Yes ... No ...

5 TYPE OF BLANK CASING USED:
 1 Steel 3 RMP (SR) 5 Wrought 7 Fiberglass 9 Other (specify below)
 2 PVC 4 ABC 6 Asbestos-Cement 8 Concrete Tile
 Blank casing diameter 2 in. Was casing pulled? Yes x No If yes, how much removed 3 ft
 Casing height above or below land surface -36 in.

6 GROUT PLUG MATERIAL: 1 Neat cement 2 Cement grout 3 Bentonite 4 Other
 Grout Plug Intervals From 0 ft. to 36 ft. From ft. to ft. From ft. to ft.

- What is the nearest source of possible contamination:
- 1 Septic tank
 - 2 Sewer lines
 - 3 Watertight sewer lines
 - 4 Lateral lines
 - 5 Cess Pool
 - 6 Seepage pit
 - 7 Pit privy
 - 8 Sewage lagoon
 - 9 Feedyard
 - 10 Livestock pens
 - 11 Fuel storage
 - 12 Fertilizer storage
 - 13 Insecticide storage
 - 14 Abandoned water well
 - 15 Oil well/ Gas well
 - 16 Other (specify below)

Direction from well? How many feet?

FROM	TO	CODE	PLUGGING MATERIALS
0	36		Bentonite grout

RECEIVED
 JAN 08 2009
 BUREAU OF WATER

7 CONTRACTOR'S OR LANDOWNER'S CERTIFICATION: This water well was plugged under my jurisdiction and was completed on (mo/day/yr) 10/9/08 and this record is true to the best of my knowledge and belief. Kansas Water Well Contractor's License No. 554 This Water Well Record was completed on (mo/day/yr) 10/22/08 under the business name of Bluestem Environmental Engineering, Inc. by (signature) [Signature]

INSTRUCTIONS: Please fill in blanks and circle the correct answers. Send three copies to Kansas Department of Health and Environment, Bureau of Water, 1000 S W Jackson St., Ste. 420, Topeka, Kansas 66620-0001. Telephone: 785-298-3555. Send one to Water Well Owner and retain one for your records.