USE TYPEWRITER OR BALL POINT PEN-PRESS-FIRMLly, PRINT CLEARLY.

3	19	W	10	SWSWNE
T	R	EW	sec	1/4 1/4 1/4 No.

WATER WELL RECORD
KSA 82a-1201-1215

Stuttgart

Kansas State Dept. Of Health
(Water Well Contractors)
Forbes-Bldg. 740
Topeka, Kansas 66620

1 Location of well:	County	Township name	Fraction	Section number	Town number	Range number
	Phillips	mound	SWSWNE	10	T-3-S	R-19-W

Distance and direction from nearest town or city: ½ mile east stuttgart
Street address of well location if in city:

3 Owner of well: Paul Beyerlein
Address: Stuttgart kansas

Locate with "X" in section below: Sketch map:

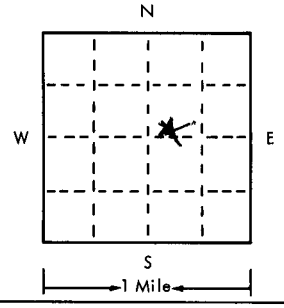

2

Type and color of material	From	To
clay	0	30
rock & gravel	30	50
Hardpan ?		
(use a second sheet if needed)		

4 Well depth: 50 ft. Date of completion 5-9
Well diameter 11 in.

5 ☐ Cable tool ☒ Rotary ☐ Driven ☐ Dug ☐ Hollow rod ☐ Jetted ☐ Bored ☐ Reverse rotary

6 Use: ☐ Domestic ☐ Public supply ☐ Industry ☐ Irrigation ☐ Air conditioning ☐ Commercial ☐ Test well ☒ stock well

7 Casing: Material plastic Height: (above) below
Threaded ☐ Welded ☐ Surface 12 in.
Diam. 5" RMP Weight 200 lbs./ft.
5 in. to 50 ft. depth Drive shoe? ☐ Yes ☒ No
___ in. to ___ ft. depth

8 Screen:
Manufacturer Jess + Lowell
Type RMP Dia. 5"
Slot/gauze 18 Length 15'
Set between 35 ft. and 50 ft.
Fittings:
Gravel pack ☒ Yes ☐ No Size range of material 1/4

9 Static water level: 21 ft. below land surface Date 5-9-75

10 Pumping level below land surfaces: 16 ft. after ___ hrs. pumping 15 g.p.m.
___ ft. after ___ hrs. pumping ___ g.p.m.
Estimated maximum yield ___ g.p.m.

11 Water sample submitted: ☐ Yes ☒ No Date ___

12 Well head completion: ☐ Pitless adapter ☐ Inches above grade

13 Well grouted? ☒ Yes ☐ No
☒ Neat cement ☒ Bentonite ☐ ___
Depth: From 0 ft. to 10 ft.

14 Nearest source of possible contamination: Barn
ft. 1000 Direction N Type yard
Well disinfected upon completion? ☒ Yes ☐ No

15 Pump: ☒ Not installed
Manufacturer's name ___
Model number ___ HP ___ Volts ___
Length of drop pipe ___ ft. capacity ___ g.m.p.
Type: ☐ Submersible ☐ Turbine ☐ Jet ☐ Reciprocating ☐ Certrifugal ☐ Other

16 Remarks: elevation 2000

Topography:
☐ Hill
☐ Slope
☐ Upland
☒ Valley

17 Water well contractor's certification:
This well was drilled under my jurisdiction and this report is true to the best of my knowledge and belief.
Business name Pellinger Drilling License No. 229A
Address 638 Old Phillipsburg Rd
Signed Darrell Pellinger Date 5-29-75
Authorized representative

3 19 W 10 SWSWNE

Forward the white, blue and pink copies to the Kansas State Dept. Of Health.

Form WWC-5