


1 LOCATION OF WATER WELL: County: Phillips Fraction: SW 1/4 NW 1/4 NE 1/4 Section Number: 15 Township Number: T 3 S Range Number: R 19 EW
 Distance and direction from nearest town or city street address of well if located within city? Stuttgart, KS lot 22-23-24 BIK 4

2 WATER WELL OWNER: Alma L. Veek Estate
 RR#, St. Address, Box #: Stuttgart, Kansas 67670 Board of Agriculture, Division of Water Resources
 City, State, ZIP Code: Stuttgart, Kansas 67670 Application Number:

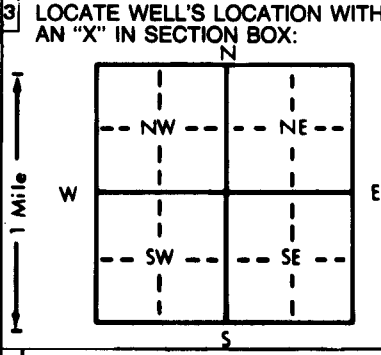

4 DEPTH OF COMPLETED WELL: 79 ft. ELEVATION: ft.
 Depth(s) Groundwater Encountered ft. 2. ft. 3. ft.
 WELL'S STATIC WATER LEVEL: 29 ft. below land surface measured on mo/day/yr 5-10-87
 Pump test data: Well water was ft. after hours pumping gpm
 Est. Yield 30 gpm: Well water was ft. after hours pumping gpm
 Bore Hole Diameter: 9 in. to 79 ft., and in. to ft.
 WELL WATER TO BE USED AS:
 1 Domestic 3 Feedlot 6 Oil field water supply 9 Dewatering 12 Other (Specify below)
 2 Irrigation 4 Industrial 7 Lawn and garden only 10 Observation well
 Was a chemical/bacteriological sample submitted to Department? Yes.....No.....; If yes, mo/day/yr sample was submitted
 Water Well Disinfected? Yes No

5 TYPE OF BLANK CASING USED:
 1 Steel 2 PVC 3 RMP (SR) 4 ABS 5 Wrought iron 6 Asbestos-Cement 7 Fiberglass 8 Concrete tile 9 Other (specify below)
 CASING JOINTS: Glued X Clamped
 Welded
 Threaded
 Blank casing diameter: 5 in. to 79 ft., Dia in. to ft., Dia in. to ft.
 Casing height above land surface: 12 in., weight 160 lbs./ft. Wall thickness or gauge No.
 TYPE OF SCREEN OR PERFORATION MATERIAL:
 1 Steel 2 Brass 3 Stainless steel 4 Galvanized steel 5 Fiberglass 6 Concrete tile 7 PVC 8 RMP (SR) 9 ABS 10 Asbestos-cement 11 Other (specify)
 12 None used (open hole)
 SCREEN OR PERFORATION OPENINGS ARE:
 1 Continuous slot 2 Louvered shutter 3 Mill slot 4 Key punched 5 Gauzed wrapped 6 Wire wrapped 7 Torch cut 8 Saw cut 9 Drilled holes 10 Other (specify)
 11 None (open hole)
 SCREEN-PERFORATED INTERVALS: From 69 ft. to 79 ft., From ft. to ft.
 From ft. to ft., From ft. to ft.
 GRAVEL PACK INTERVALS: From 60 ft. to 79 ft., From ft. to ft.
 From ft. to ft., From ft. to ft.

6 GROUT MATERIAL: 1 Neat cement 2 Cement grout 3 Bentonite 4 Other
 Grout Intervals: From 10 ft. to ft., From 60 ft. to ft., From ft. to ft.
 What is the nearest source of possible contamination:
 1 Septic tank 2 Sewer lines 3 Watertight sewer lines 4 Lateral lines 5 Cess pool 6 Seepage pit 7 Pit privy 8 Sewage lagoon 9 Feedyard 10 Livestock pens 11 Fuel storage 12 Fertilizer storage 13 Insecticide storage 14 Abandoned water well 15 Oil well/Gas well 16 Other (specify below)
 Direction from well? North How many feet? 40 ft

FROM	TO	LITHOLOGIC LOG	FROM	TO	LITHOLOGIC LOG
0	20	Clay			
20	62	Creek Mudd			★ this well was grouted to block upper aquifer
62	65	Creek Mudd			
65	75	mudd balls + sand some gravel			
75	79	Shale			

7 CONTRACTOR'S OR LANDOWNER'S CERTIFICATION: This water well was constructed (2) reconstructed, or (3) plugged under my jurisdiction and was completed on (mo/day/year) 5-10-87 and this record is true to the best of my knowledge and belief. Kansas Water Well Contractor's License No. 386 This Water Well Record was completed on (mo/day/yr) 5-10-87 under the business name of DH Enterprises by (signature) Paul Ott