WATER WELL PLUGGING RECORD Form WWC-5P KSA 82a-1212 ID NO.

1 LOCATION OF WATER WELL: County: Logan	Fraction	Section Number	Township Number	Range Number
	NW ¼ NW ¼ NW ¼	19	11	35 E/W X

Distance and direction from nearest town or city street address of well if located within city?
2 miles north & 3/4 mile west of Winona

2 WATER WELL OWNER: Kevin Tubbs
RR#, St. Address, Box #: 7303 Rd. E10
City, State ZIP Code: Almena, KS 67622

Global Positioning Systems (decimal degrees, min. of 4 digits
Latitude: _____
Longitude: _____
Elevation: _____
Datum: _____
Data Collection Method:

3 MARK WELL'S LOCATION WITH AN "X" IN SECTION BOX:

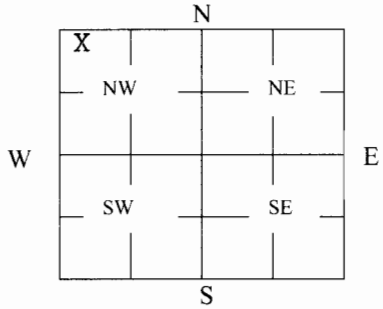

4 DEPTH OF WELL 76 **ft.**

WELL'S STATIC WATER LEVEL 58 ft

WELL WAS USED AS:

1 Domestic X	5 Public Water Supply	9 Dewatering
2 Irrigation	6 Oil Field Water Supply	10 Monitoring
3 Feedlot	7 Domestic (Lawn & Garden)	11 Injection Well
4 Industrial	8 Air Conditioning	12 Other _____

Was a chemical/bacteriological sample submitted to Department? Yes_____ No X

5 TYPE OF BLANK CASING USED:

1 Steel	3 RMP (SR)	5 Wrought	7 Fiberglass	9 Other (Specify below) X
2 PVC	4 ABS	6 Asbestos-Cement	8 Concrete Tile	styreen

Blank casing diameter 5 in. Was casing pulled? Yes X No _____ If yes, how much 20ft.
Casing height above or below land surface 240 in.

6 GROUT PLUG MATERIAL: 1 Neat cement X 2 Cement grout 3 Bentonite 4 Other _____

Grout Plug Intervals: From 58 ft. to 48 ft., From 30 ft. to 20 ft., From _____ to _____ ft.

What is the nearest source of possible contamination:

1 Septic tank	6 Seepage pit	11 Fuel Storage	16 Other (specify below) X
2 Sewer lines	7 Pit privy	12 Fertilizer storage	farm ground
3 Watertight sewer lines	8 Sewage lagoon	13 Insecticide storage	
4 Lateral lines	9 Feedyard	14 Abandoned water well	Direction from well? all around
5 Cess pool	10 Livestock pens	15 Oil well/Gas well	How many feet? _____

FROM	TO	PLUGGING MATERIALS	FROM	TO	PLUGGING MATERIALS
76	58	gravel			
58	48	grout			
48	30	clean soil			
30	20	grout			
20	0	clean soil			

7 CONTRACTOR'S OR LANDOWNER'S CERTIFICATION: This water well was plugged under my jurisdiction and was completed on (mo/day/year) 3-29-10 and this record is true to the best of my knowledge and belief. Kansas Water Well Contractor's License No. 649. This Water Well Record was completed on (mo/day/year) 4-7-10 under the business name of Bartell Drilling by (signature) Darlene Bartell.

INSTRUCTIONS: Use typewriter or ballpoint pen. Please press firmly and print clearly. Please fill in blanks, underline or circle the correct answers. Send top three copies to Kansas Department of Health and Environment, Bureau of Water, Geology Section, 1000 SW Jackson St., Ste. 420, Topeka, Kansas 66612-1367. Telephone: 785/296-5522. Send one to Water Well Owner and retain one for your records. Visit us at http://www.kdheks.gov/geo/waterwells.