

CORRECTION(S) TO WATER WELL RECORD (WWC-5)
(to rectify lacking or incorrect information)

County: Norton

Location listed as:

Section-Township-Range: 2-2-3-21W

Fraction (¼ ¼ ¼): NE

Location changed to:

2-3S-21W

NE SE NE

Other changes: Initial statements: _____

Changed to: _____

Comments: _____

verification method: Legal description, county ownership map,
and mapping tool & aerial photos on KGS website.


initials: DR date: 4/8/2010

submitted by: Kansas Geological Survey, Data Resources Library, 1930 Constant Ave., Lawrence, KS 66047-3726
to: Kansas Dept of Health & Environment, Bureau of Water, 1000 SW Jackson, Suite 420, Topeka, KS 66612-1367.

1 LOCATION OF WATER WELL: Fraction NE 1/4 1/4 1/4 Section Number 2 Township Number 2-3 Range Number 21 EW
 County: Norton

Distance and direction from nearest town or city street address of well if located within city?

2 WATER WELL OWNER: Clarence Tien
 RR #, St. Address, Box #: 931W 1100 Rd
 City, State, ZIP Code: Prairie View, KS 67664 Board of Agriculture, Division of Water Resources
 Application Number: _____

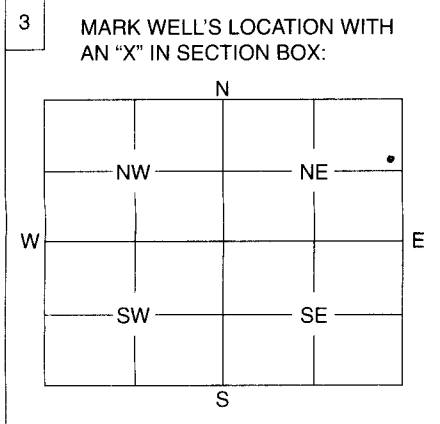

4 DEPTH OF WELL 100 ft.
 WELL'S STATIC WATER LEVEL 98 ft.
 WELL WAS USED AS:
 1 Domestic 5 Public Water Supply 9 Dewatering
 2 Irrigation 6 Oil Field Water Supply 10 Monitoring Well
 3 Feedlot 7 Domestic (Lawn & Garden) 11 Injection Well
 4 Industrial 8 Air Conditioning 12 Other _____
 Was a chemical / bacteriological sample submitted to Department? Yes _____ No
 If yes, mo/day/yr sample was submitted _____
 Water Well Disinfected: Yes No _____

5 TYPE OF BLANK CASING USED:
 1 Steel 3 RMP (SR) 5 Wrought 7 Fiberglass 9 Other (Specify below)
 2 PVC 4 ABS 6 Asbestos-Cement 8 Concrete Tile _____
 Blank casing diameter 4 in. Was casing pulled? Yes No _____ If yes, how much 3'
 Casing height above or below land surface 36 in.

6 GROUT PLUG MATERIAL: 1 Neat cement 2 Cement grout 3 Bentonite 4 Other _____
 Grout Plug Intervals: From 97 ft. to 95 ft., From 3 ft. to 20 ft., From _____ to _____ ft.
 What is the nearest source of possible contamination:
 1 Septic tank 6 Seepage pit 11 Fuel storage 16 Other (specify below)
 2 Sewer lines 7 Pit privy 12 Fertilizer storage _____
 3 Watertight sewer lines 8 Sewage lagoon 13 Insecticide storage _____
 4 Lateral lines 9 Feedyard 14 Abandoned water well _____
 5 Cess pool 10 Livestock pens 15 Oil well/Gas well _____
 Direction from well? West How many feet? 100'

FROM	TO	PLUGGING MATERIALS
97	100	sand
95	97	Bentonite
20	95	clay
3	20	Bentonite
C	3	clay

7 CONTRACTOR'S OF LANDOWNER'S CERTIFICATION: This water well was plugged under my jurisdiction and was completed on (mo/day/year) 3-12-10 and this record is true to the best of my knowledge and belief. Kansas Water Well Contractor's License No. 256 This Water Well Record was completed on (mo/day/year) 3-22-10 under the business name of Callentine Well
 by (signature) Doug Hall

INSTRUCTIONS: Use typewriter or ball point pen. Please press firmly and print clearly. Please fill in blanks, underline or circle the correct answers. Send top three copies to Kansas Department of Health and Environment, Bureau of Water, Geology Section, 1000 SW Jackson St., Ste. 420, Topeka, Kansas 66612-1367. Telephone: 785/296-5522. Send one to Water Well Owner and retain one for your records.