

CORRECTION(S) TO WATER WELL RECORD (WWC-5)
(to rectify lacking or incorrect information)

County: Norton

Location listed as:

Section-Township-Range: 2-2-35-21W

Fraction (1/4 1/4 1/4): NE

Location changed to:

2-35-21W

NE SE NE

Other changes: Initial statements: _____

Changed to: _____

Comments: _____

verification method: Legal description, county ownership map,
and mapping tool & aerial photos on KGS website.

initials: DRJ date: 4/8/2010


submitted by: Kansas Geological Survey, Data Resources Library, 1930 Constant Ave., Lawrence, KS 66047-3726
to: Kansas Dept of Health & Environment, Bureau of Water, 1000 SW Jackson, Suite 420, Topeka, KS 66612-1367.

WATER WELL RECORD

Form WWC-5

Division of Water Resources App. No. _____

1 LOCATION OF WATER WELL: County: <u>Norton</u>	Fraction <u>NE</u> $\frac{1}{4}$ $\frac{1}{4}$ $\frac{1}{4}$ $\frac{1}{4}$	Section Number <u>2</u>	Township No. <u>T 2-3 S</u>	Range Number <u>R 21</u> <input type="checkbox"/> E <input checked="" type="checkbox"/> W
Street/Rural Address of Well Location; if unknown, distance & direction from nearest town or intersection: If at owner's address, check here <input type="checkbox"/> .		Global Positioning System (GPS) information: Latitude: (in decimal degrees) Longitude: (in decimal degrees) Elevation: Datum: <input type="checkbox"/> WGS 84, <input type="checkbox"/> NAD 83, <input type="checkbox"/> NAD 27 Collection Method: <input type="checkbox"/> GPS unit (Make/Model:) <input type="checkbox"/> Digital Map/Photo, <input type="checkbox"/> Topographic Map, <input type="checkbox"/> Land Survey Est. Accuracy: <input type="checkbox"/> <3 m, <input type="checkbox"/> 3-5 m, <input type="checkbox"/> 5-15 m, <input type="checkbox"/> >15 m		
2 WATER WELL OWNER: <u>Clarence Tiers</u> RR#, Street Address, Box #: <u>931 W 1100 Rd,</u> City, State, ZIP Code: <u>Prater View, KS 67664</u>				

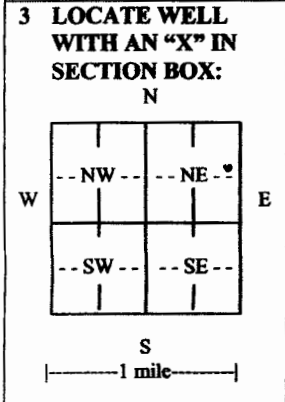

4 DEPTH OF COMPLETED WELL 160 ft.

Depth(s) Groundwater Encountered (1)..... ft. (2)..... ft. (3)..... ft.

WELL'S STATIC WATER LEVEL 128 ft. below land surface measured on mo/day/yr. 2-24-10

Pump test data: Well water was..... ft. after..... hours pumping..... gpm

EST. YIELD 10 gpm. Well water was..... ft. after..... hours pumping..... gpm

Bore Hole Diameter 8 in. to..... ft., and..... in. to..... ft.

WELL WATER TO BE USED AS: Public water supply Geothermal Injection well

Domestic Feedlot Oil field water supply Dewatering Other (Specify below)

Irrigation Industrial Domestic-lawn & garden Monitoring well

Was a chemical/bacteriological sample submitted to Department? Yes No

If yes, mo/day/yr sample was submitted.....

Water well disinfected? Yes No

5 TYPE OF CASING USED: Steel PVC Other

CASING JOINTS: Glued Clamped Welded Threaded

Casing diameter 5 in. to 160 ft., Diameter..... in. to..... ft., Diameter..... in. to..... ft.

Casing height above land surface 36 in., Weight..... lbs./ft., Wall thickness or gauge No. 200 RST

TYPE OF SCREEN OR PERFORATION MATERIAL:

Steel Stainless Steel PVC Other (Specify)

Brass Galvanized Steel None used (open hole)

SCREEN OR PERFORATION OPENINGS ARE:

Continuous slot Mill slot Gauze wrapped Torch cut Drilled holes None (open hole)

Louvered shutter Key punched Wire wrapped Saw cut Other (specify)

SCREEN-PERFORATED INTERVALS: From 120 ft. to 160 ft., From..... ft. to..... ft.

From..... ft. to..... ft., From..... ft. to..... ft.

GRAVEL PACK INTERVALS: From 20 ft. to 160 ft., From..... ft. to..... ft.

From..... ft. to..... ft., From..... ft. to..... ft.

6 GROUT MATERIAL: Neat cement Cement grout Bentonite Other

Grout Intervals: From 3 ft. to 20 ft., From..... ft. to..... ft., From..... ft. to..... ft.

What is the nearest source of possible contamination:

Septic tank Lateral lines Pit privy Livestock pens Insecticide storage Other (specify below)

Sewer lines Cesspool Sewage lagoon Fuel storage Abandoned water well

Watertight sewer lines Seepage pit Feedyard Fertilizer storage Oil well/gas well

Direction from well W. S. E. Distance from well 100'

FROM	TO	LITHOLOGIC LOG	FROM	TO	LITHO. LOG (cont.) or PLUGGING INTERVALS
0	5	Black Dirt			
5	25	brown clay			
25	50	brown-gray clay			
50	60	gray clay - fine sand			
60	80	green-gray clay			
80	110	green-gray clay, fine sand			
110	130	brown clay, med. sand			
130	140	brown clay, coarse sand			
140	160	Soft sandstone, coarse sand			

7 CONTRACTOR'S OR LANDOWNER'S CERTIFICATION: This water well was constructed, reconstructed, or plugged under my jurisdiction and was completed on (mo/day/year) 2-23-10 and this record is true to the best of my knowledge and belief.

Kansas Water Well Contractor's License No. 754 This Water Well Record was completed on (mo/day/year) 2-23-10

under the business name of Gallentine Well by (signature) Clarence Tiers

INSTRUCTIONS: Use typewriter or ball point pen. PLEASE PRESS FIRMLY and PRINT clearly. Please fill in blanks and check the correct answers. Send three copies (white, blue, pink) to Kansas Department of Health and Environment, Bureau of Water, Geology Section, 1000 SW Jackson St., Suite 420, Topeka, Kansas 66612-1367. Telephone 785-296-5522. Send one copy to WATER WELL OWNER and retain one for your records. Include fee of \$5.00 for each constructed well. Visit us at <http://www.kdheks.gov/waterwell/index.html>.

white