


1 LOCATION OF WATER WELL: Fraction Section Number Township Number Range Number  
 County: Norton 1/4 W1/2 1/4 SW 1/4 32 T 3 S R 22 EW

Distance and direction from nearest town or city street address of well if located within city?

2 WATER WELL OWNER: Scott Evans  
 RR#, St. Address, Box #: RR 3 Box 47 Board of Agriculture, Division of Water Resources  
 City, State, ZIP Code: Norton, Ks. 67654 Application Number:

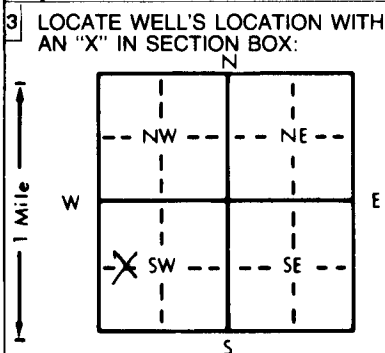

4 DEPTH OF COMPLETED WELL: 215 ft. ELEVATION:  
 Depth(s) Groundwater Encountered 1 139 ft. 2 ft. 3 ft.  
 WELL'S STATIC WATER LEVEL 139 ft. below land surface measured on mo/day/yr  
 Pump test data: Well water was ft. after hours pumping gpm  
 Est. Yield gpm: Well water was ft. after hours pumping gpm  
 Bore Hole Diameter 8 in. to 215 ft., and in. to ft.  
 WELL WATER TO BE USED AS: 5 Public water supply 8 Air conditioning 11 Injection well  
 1 Domestic 3 Feedlot 6 Oil field water supply 9 Dewatering 12 Other (Specify below)  
 2 Irrigation 4 Industrial 7 Lawn and garden only 10 Monitoring well  
 Was a chemical/bacteriological sample submitted to Department? Yes No X; If yes, mo/day/yr sample was submitted Water Well Disinfected? Yes X No

5 TYPE OF BLANK CASING USED: 5 Wrought iron 8 Concrete tile CASING JOINTS: Glued X Clamped  
 1 Steel 3 RMP (SR) 6 Asbestos-Cement 9 Other (specify below) Welded  
 2 PVC 4 ABS 7 Fiberglass Threaded  
 Blank casing diameter 4.5 in. to 175 ft. Dia in. to ft. Dia in. to ft.  
 Casing height above land surface 18 in. weight 2.38 lbs./ft. Wall thickness or gauge No. 248  
 TYPE OF SCREEN OR PERFORATION MATERIAL: 7 PVC 10 Asbestos-cement  
 1 Steel 3 Stainless steel 5 Fiberglass 8 RMP (SR) 11 Other (specify)  
 2 Brass 4 Galvanized steel 6 Concrete tile 9 ABS 12 None used (open hole)  
 SCREEN OR PERFORATION OPENINGS ARE: 5 Gauzed wrapped 8 Saw cut 11 None (open hole)  
 1 Continuous slot 3 Mill slot 6 Wire wrapped 9 Drilled holes  
 2 Louvered shutter 4 Key punched 7 Torch cut 10 Other (specify)  
 SCREEN-PERFORATED INTERVALS: From 175 ft. to 215 ft. From ft. to ft.  
 From ft. to ft. From ft. to ft.  
 GRAVEL PACK INTERVALS: From 20 ft. to 215 ft. From ft. to ft.  
 From ft. to ft. From ft. to ft.

6 GROUT MATERIAL: 1 Neat cement 2 Cement grout 3 Bentonite 4 Other  
 Grout Intervals: From 0 ft. to 20 ft. From ft. to ft. From ft. to ft.  
 What is the nearest source of possible contamination:  
 1 Septic tank 4 Lateral lines 7 Pit privy 10 Livestock pens 14 Abandoned water well  
 2 Sewer lines 5 Cess pool 8 Sewage lagoon 11 Fuel storage 15 Oil well/Gas well  
 3 Watertight sewer lines 6 Seepage pit 9 Feedyard 12 Fertilizer storage 16 Other (specify below)  
 13 Insecticide storage NONE

Direction from well? How many feet?

FROM	TO	LITHOLOGIC LOG	FROM	TO	PLUGGING INTERVALS
0	2	Surface	137	140	Med. Sand/Caliche Strks.
2	14	Loess	140	143	Sandstone & Clay
14	28	Sandy Clay w/Caliche Strks.	143	158	Clay & Fine Sand Strks.
28	35	Caliche & Clay	158	158.5	Caliche
35	39	Sandstone	158.5	168	Sandstone Clay & Caliche Strk
39	41	Caliche	168	174	Sand & Sandstone
41	50	Clay & Sand Strks.	174	183	Fine Sand
50	59	Sandstone, Caliche & Clay	183	184	Caliche
59	70	Green Sticky Clay	184	200	Fine to Med. Sand, Clay &
70	83	Caliche Clay & Sand Strks.			Caliche Strk
83	93	Green Sticky Clay	200	215	Fine to Med. Sand w/Clay
93	101	Clay & Sand			& Sandstone
101	125	Med. Sand/Clay Strks.			
125	127	Caliche			
127	137	Caliche, Cemented Sand, Clay & Sand Strks.			

7 CONTRACTOR'S OR LANDOWNER'S CERTIFICATION: This water well was (1) constructed, (2) reconstructed, or (3) plugged under my jurisdiction and was completed on (mo/day/year) 3-2-96 and this record is true to the best of my knowledge and belief. Kansas Water Well Contractor's License No. 554 This Water Well Record was completed on (mo/day/yr) 3-12-96 under the business name of Woofter Pump & Well, Inc. by (signature)

INSTRUCTIONS: Use typewriter or ball point pen. PLEASE PRESS FIRMLY and PRINT clearly. Please fill in blanks, underline or circle the correct answers. Send top three copies to Kansas Department of Health and Environment, Bureau of Water, Topeka, Kansas 66620-0001. Telephone: 913-296-5545. Send one to WATER WELL OWNER and retain one for your records.