


1 LOCATION OF WATER WELL: Fraction SW 1/4 SE 1/4 SE 1/4 Section Number 31 Township Number T 3 S Range Number R 22 E 10
 County: Norton

Distance and direction from nearest town or city street address of well if located within city?

2 WATER WELL OWNER: Scott Evans
 RR#, St. Address, Box # : Rt. 3 Box 47 Board of Agriculture, Division of Water Resources
 City, State, ZIP Code : Norton, Ks. 67654 Application Number: 42,152

3 LOCATE WELL'S LOCATION WITH AN "X" IN SECTION BOX:

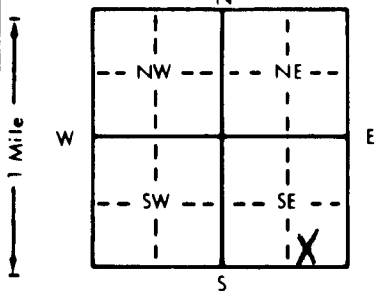

4 DEPTH OF COMPLETED WELL: 273 ft. ELEVATION:

Depth(s) Groundwater Encountered 1. 125 ft. 2. _____ ft. 3. _____ ft.
 WELL'S STATIC WATER LEVEL 125 ft. below land surface measured on mo/day/yr
 Pump test data: Well water was _____ ft. after _____ hours pumping _____ gpm
 Est. Yield _____ gpm: Well water was _____ ft. after _____ hours pumping _____ gpm
 Bore Hole Diameter 24 in. to 273 ft., and _____ in. to _____ ft.
 WELL WATER TO BE USED AS: 5 Public water supply 8 Air conditioning 11 Injection well
 1 Domestic 3 Feedlot 6 Oil field water supply 9 Dewatering 12 Other (Specify below)
2 Irrigation 4 Industrial 7 Lawn and garden only 10 Monitoring well
 Was a chemical/bacteriological sample submitted to Department? Yes _____ No X; If yes, mo/day/yr sample was submitted
 Water Well Disinfected? Yes _____ No X

5 TYPE OF CASING USED: 1 Steel 3 RMP (SR) 5 Wrought iron 8 Concrete tile CASING JOINTS: Glued X Clamped _____
 2 PVC 4 ABS 6 Asbestos-Cement 9 Other (specify below) Welded _____
 7 Fiberglass Threaded _____

Blank casing diameter 16 in. to 213 ft., Dia _____ in. to _____ ft., Dia _____ in. to _____ ft.
 Casing height above land surface 24 in., weight 16.15 lbs./ft. Wall thickness or gauge No. 500

TYPE OF SCREEN OR PERFORATION MATERIAL: 7 PVC 10 Asbestos-cement
 1 Steel 3 Stainless steel 5 Fiberglass 8 RMP (SR) 11 Other (specify) _____
 2 Brass 4 Galvanized steel 6 Concrete tile 9 ABS 12 None used (open hole)

SCREEN OR PERFORATION OPENINGS ARE: 5 Gauzed wrapped 8 Saw cut 11 None (open hole)
 1 Continuous slot 3 Mill slot 6 Wire wrapped 9 Drilled holes
 2 Louvered shutter 4 Key punched 7 Torch cut 10 Other (specify) _____

SCREEN-PERFORATED INTERVALS: From 213 ft. to 273 ft., From _____ ft. to _____ ft.
 From _____ ft. to _____ ft., From _____ ft. to _____ ft.
 GRAVEL PACK INTERVALS: From 20 ft. to 273 ft., From _____ ft. to _____ ft.
 From _____ ft. to _____ ft., From _____ ft. to _____ ft.

6 GROUT MATERIAL: 1 Neat cement 2 Cement grout 3 Bentonite 4 Other _____
 Grout Intervals: From 0 ft. to 20 ft., From _____ ft. to _____ ft., From _____ ft. to _____ ft.

What is the nearest source of possible contamination:
 1 Septic tank 4 Lateral lines 7 Pit privy 10 Livestock pens 14 Abandoned water well
 2 Sewer lines 5 Cess pool 8 Sewage lagoon 11 Fuel storage 15 Oil well/Gas well
 3 Watertight sewer lines 6 Seepage pit 9 Feedyard 12 Fertilizer storage 16 Other (specify below)
 13 Insecticide storage

Direction from well? _____ How many feet? _____

FROM	TO	LITHOLOGIC LOG	FROM	TO	PLUGGING INTERVALS
0	2	Surface	132	139	Sandstone w/Sand Strks. &
2	10	Loess	139	140	Med. Sand w/a Few Clays. Clay
10	19	Fine to Med. Sand w/Clay Str.	140	152	Sandy Clay w/Sand Strks.
19	36	Cemented Sand w/Clay & Caliche	152	159	Fine to Med. Sand w/Clay
36	42	Cemented Sand w/Clay & Fine Sand Strks.	159	163	Cemented Sand w/Clay
42	51	Fine Sand w/Clay & a Few Cem.	163	170	Sandstone w/Sand Strks.
51	76	Sandy Clay w/Sand Strk St.	170	178	Med. Sand w/a Few Fine Clay
76	86	Fine to Med. Sand w/Clay Strk	178	180	Sandy Clay w/S. Sand Ln
86	102	Sandy Clay	180	214	Fine Sand w/a Few Clay Lns.
102	116	Fine-Med. Sand w/Clay Strks.	214	224	Fine Sand w/Clay Strks.
116	127	Sandy Clay w/Sand Strks.	224	242	Fine Sand w/a Few Fine Clay
127	128	Cemented Sand	242	274	Clay w/Fine Sand Strks. Ln
128	130	Sandy Clay	274		Ochre
130	132	Fine to Med. Sand			

7 CONTRACTOR'S OR LANDOWNER'S CERTIFICATION: This water well was (1) constructed, (2) reconstructed, or (3) plugged under my jurisdiction and was completed on (mo/day/year) 3-26-91 and this record is true to the best of my knowledge and belief. Kansas Water Well Contractor's License No. 554 This Water Well Record was completed on (mo/day/yr) 4-1-91 under the business name of Woofter Pump & Well, Inc. by (signature) Gayle Woofter

INSTRUCTIONS: Use typewriter or ball point pen. PLEASE PRESS FIRMLY and PRINT clearly. Please fill in blanks, underline or circle the correct answers. Send top three copies to Kansas Department of Health and Environment, Bureau of Water, Topeka, Kansas 66620-0001. Telephone: 913-296-5545. Send one to WATER WELL OWNER and retain one for your records.