


1 LOCATION OF WATER WELL: Fraction **NE 1/4 NW 1/4 NW 1/4** Section Number **27** Township Number **T 3 S** Range Number **R 22** EAM
 County: **Norton**

Distance and direction from nearest town or city street address of well if located within city?

2 WATER WELL OWNER: **Esslinger Ranch**
 RR#, St. Address, Box #: **Rt. 3 Box 45** Board of Agriculture, Division of Water Resources
 City, State, ZIP Code: **Norton, KS 67654** Application Number:

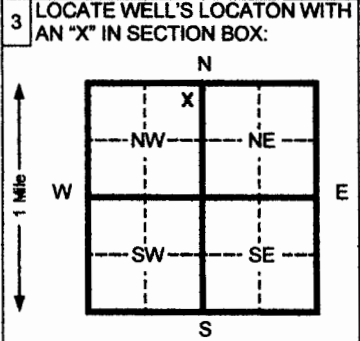

4 DEPTH OF COMPLETED WELL **195** ft. ELEVATION: _____
 Depth(s) Groundwater Encountered 1 _____ ft. 2 _____ ft. 3 _____ ft.
 WELL'S STATIC WATER LEVEL **144** ft. below land surface measured on mo/day/yr
 Pump test data: Well water was _____ ft. after _____ hours pumping _____ gpm
 Est. Yield _____ gpm: Well water was _____ ft. after _____ hours pumping _____ gpm
 Bore Hole Diameter **8** in. to **200** ft. and _____ in. to _____ ft.
 WELL WATER TO BE USED AS: 5 Public water supply 8 Air conditioning 11 Injection well
 ① Domestic 3 Feed lot 6 Oil field water supply 9 Dewatering 12 Other (Specify below)
 2 Irrigation 4 Industrial 7 Lawn and garden (domestic) 10 Monitoring well
 Was a chemical/bacteriological sample submitted to Department? Yes _____ No **X** If yes, mo/day/yr sample was submitted _____
 Water Well Disinfected? Yes **X** No _____

5 TYPE OF BLANK CASING USED:
 1 Steel 3 RMP (SR) 5 Wrought Iron 8 Concrete tile CASING JOINTS: Glued **X** Clamped
 ② PVC 4 ABS 6 Asbestos-Cement 9 Other (specify below) Welded _____
 7 Fiberglass Threaded _____
 Blank casing diameter **4.5** in. to **160** ft. Dia _____ in. to _____ ft. Dia _____ in. to _____ ft.
 Casing height above land surface **18** in., weight **2.384** lbs./ft. Wall thickness or gauge No. **248**
 TYPE OF SCREEN OR PERFORATION MATERIAL:
 1 Steel 3 Stainless steel 5 Fiberglass ⑦ PVC 10 Asbestos-cement
 2 Brass 4 Galvanized steel 6 Concrete tile 8 RMP (SR) 11 Other (specify) _____
 9 ABS 12 None used (open hole) _____
 SCREEN OR PERFORATION OPENINGS ARE:
 1 Continuous slot 3 Mill slot 5 Gauzed wrapped ⑧ Saw cut 11 None (open hole)
 2 Louvered shutter 4 Key punched 6 Wire wrapped 9 Drilled holes _____
 7 Torch cut 10 Other (specify) _____
 SCREEN-PERFORATED INTERVALS: From **155** ft. to **195** ft. From _____ ft. to _____ ft.
 From _____ ft. to _____ ft. From _____ ft. to _____ ft.
 GRAVEL PACK INTERVALS: From **20** ft. to **195** ft. From _____ ft. to _____ ft.
 From _____ ft. to _____ ft. From _____ ft. to _____ ft.

6 GROUT MATERIAL: 1 Neat cement 2 Cement grout ③ Bentonite 4 Other _____
 Grout intervals From **0** ft. to **20** ft. From _____ ft. to _____ ft. From _____ ft. to _____ ft.
 What is the nearest source of possible contamination:
 1 Septic tank 4 Lateral lines 7 Pit privy 10 Livestock pens 14 Abandoned water well
 2 Sewer lines 5 Cess pool 8 Sewage lagoon 11 Fuel storage 15 Oil well/ Gas well
 3 Watertight sewer lines 6 Seepage pit 9 Feedyard 12 Fertilizer storage 16 Other (specify below) _____
 13 Insecticide storage **none**

Direction from well? _____ How many feet? _____

FROM	TO	CODE	LITHOLOGIC LOG	FROM	TO	PLUGGING INTERVALS
0	2		Surface	171	173	Sandstone
2	30		Loess	173	187	Fine to some medium sand
30	52		Clay & caliche	187	190	Clay and caliche
52	57		Fine sand	190	195	Fine sand
57	88		Cemented sand w/ sandstone	195	200	flint
88	94		Caliche			
94	100		Fine to med sand w/ clay and caliche			
100	121		Clay			
121	129		Fine sand			
129	139		Fine to med sand w/ clay streaks			
139	150		Clay and caliche			
150	157		Fine sand			
157	161		Caliche			
161	171		Fine sand			

7 CONTRACTOR'S OR LANDOWNER'S CERTIFICATION: This water well was (1) constructed, (2) reconstructed, or (3) plugged under my jurisdiction and was completed on (mo/day/yr) **11-28-06** and this record is true to the best of my knowledge and belief. Kansas Water Well Contractor's License No. **554** This Water Well Record was completed on (mo/day/yr) **12-28-06** under the business name of **Woofter Pump & Well, Inc.** by (signature) _____