USE TYPEWRITER OR BALL POINT PEN-PRESS FIRMLY, PRINT CLEARLY.

T R EW sec 1/4 1/4 1/4 No.

WATER WELL RECORD
KSA 82a-1201-1215

Kansas State Dept. Of Health
(Water Well Contractors)
Forbes-Bldg. 740
Topeka, Kansas 66620

1 Location of well:	County	Township name	Fraction	Section number	Town number	Range number
	Norton	Belle Plaine	NE of SW 1/4	12	3	22 - W

Distance and direction from nearest town or city: 8 mi east of Norton Kansas
Street address of well location if in city:

3 Owner of well: Derek Kats
Address: Prairie view, Kansas

Locate with "X" in section below:

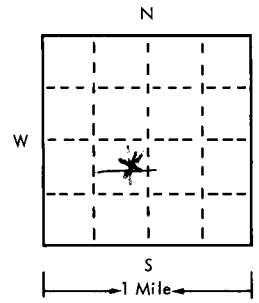

Sketch map:

4 Well depth: 160 ft. Date of completion 7/25/75
Well diameter 9 in.

5 ☐ Cable tool ☒ Rotary ☐ Driven ☐ Dug ☐ Hollow rod ☐ Jetted ☐ Bored ☐ Reverse rotary

6 Use: ☐ Domestic ☐ Public supply ☐ Industry ☐ Irrigation ☐ Air conditioning ☐ Commercial ☐ Test well ☐ Pasture

7 Casing: Material RMP Height: (above) below
Threaded ☐ Welded ☐ Surface 12 in.
Diam. 5 in. to 140 ft. depth Weight 278 lbs./ft. 100
Drive shoe? ☐ Yes ☒ No
___ in. to ___ ft. depth

2 Type and color of material	From	To
Top Soil (clay)	0	7
Sand stone (white & Grey)	7	40
Sandy clay	40	95
Sand (Medium Fine) ?	95	160
(use a second sheet if needed)		

8 Screen:
Manufacturer Modern Pipe Inc
Type PVC Dia. 5"
(Slot) gauze 032 Length 20'
Set between 140 ft. and 160 ft.
Fittings:
Gravel pack ☒ Yes ☐ No Size range of material 1/8

9 Static water level:
147 ft. below land surface Date 7/25/75

10 Pumping level below land surfaces:
___ ft. after ___ hrs. pumping ___ g.p.m.
___ ft. after ___ hrs. pumping ___ g.p.m.
Estimated maximum yield ___ g.p.m.

11 Water sample submitted:
☐ Yes ☒ No Date ___

12 Well head completion:
☐ Pitless adapter ☒ Inches above grade

13 Well grouted? ☐ Yes ☐ No
☒ Neat cement ☐ Bentonite ☐ ___
Depth: From 0 ft. to 10 ft.

14 Nearest source of possible contamination:
ft. ___ Direction None Type ___
Well disinfected upon completion? ☐ Yes ☒ No

15 Pump: ☒ Not installed
Manufacturer's name ___
Model number ___ HP ___ Volts ___
Length of drop pipe 157 ft. capacity 4 g.m.p.
Type:
☐ Submersible ☐ Turbine
☐ Jet ☒ Reciprocating
☐ Certrifugal ☐ Other

16 Remarks: elevation 3370 (Topo)

Topography:
☐ Hill
☒ Slope
☐ Upland
☐ Valley

17 Water well contractor's certification:
This well was drilled under my jurisdiction and this report is true to the best of my knowledge and belief.
Jabar B. Fawcett & Son 167
Business name License No.
Address Box 149 Norton Kans
Signed John B. Fawcett Date 8/15/75
Authorized representative

Forward the white, blue and pink copies to the Kansas State Dept. Of Health.

Form WWC-5