USE TYPEWRITER OR BALL POINT PEN-PRESS FIRMLY, PRINT CLEARLY.

WATER WELL RECORD
KSA 82a-1201-1215

Kansas Department of Health and Environment-Division of Environment
(Water well Contractors)
Topeka, Kansas 66620

BAA

1. Location of well:	County	Fraction	Section number	Township number	Range number
	Norton	NE 1/4 NE 1/4 NW 1/4	1	T 3 S	R 23 E/W

2. Distance and direction from nearest town or city: 1½ miles East of Norton Ks.
Street address of well location if in city:

3. Owner of well: Donald Johnson
R.R. or street:
City, state, zip code: Norton Kansas 67654

4. Locate with "X" in section below:

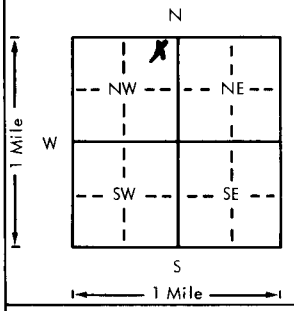

Sketch map:

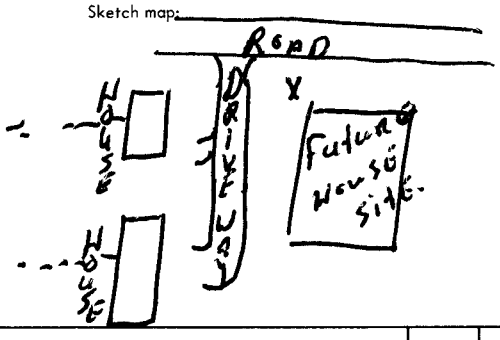

6. Bore hole dia. 9 in. Completion date
Well depth 75 ft. 3/17/77

7. __ Cable tool X Rotary __ Driven __ Dug
__ Hollow rod __ Jetted __ Bored __ Reverse rotary

8. Use: X Domestic __ Public supply __ Industry
__ Irrigation __ Air conditioning __ Stock
__ Lawn __ Oil field water __ Other

9. Casing: Material
Threaded __ Welded __
RMP PVC X
Dia. 5 in. to 55 ft. depth
Dia. in. to ft. depth
Height: Above or below Surface 12 in.
Weight .275 lbs./ft.
Wall Thickness: inches or gage No. 250

10. Screen: Manufacturer's name Modern Pipes Inc.
Type PVC Dia. 5"
Slot/gauze .032 Length 20
Set between 55 ft. and 75 ft.
ft. and ft.
Gravel pack? YES Size range of material 1/8 x 1/4

11. Static water level: mo./day/yr.
35 ft. below land surface Date 3/17/77

12. Pumping level below land surfaces:
ft. after hrs. pumping g.p.m.
ft. after hrs. pumping g.p.m.
Estimated maximum yield 35 g.p.m.

13. Water sample submitted: mo./day/yr.
__ Yes X No Date

14. Well head completion:
__ Pitless adapter 24 Inches above grade

15. Well grouted? YES
With: __ Neat cement __ Bentonite X Concrete
Depth: From 4 ft. to 14 ft.

16. Nearest source of possible contamination:
ft. 200' Direction West Type Sewer
Well disinfected upon completion? X Yes __ No

17. Pump: X Not installed
Manufacturer's name
Model number HP Volts
Length of drop pipe ft. capacity g.p.m.
Type:
__ Submersible __ Turbine
__ Jet __ Reciprocating
__ Centrifugal __ Other

5. Type and color of material	From	To
Clay, Black	0	10
Clay, Tan	10	48
Sand	48	71
Clay, Shale.	71	75
73		
35		
38' set thru		
in Oil		

(Use a second sheet if needed)

18. Elevation:
Topography:
__ Hill
X Slope
__ Upland
__ Valley

19. Remarks: 3345 (Topo)

20. Water well contractor's certification:
This well was drilled under my jurisdiction and this report is true to the best of my knowledge and belief.
Fawcett & Son Drilling 167
Business name License No.
Address Box 149, Norton Ks
Signed [signature] Date 3/17/77
Authorized representative

T 3 R 23 E/W Sec 1 1/4 NE 1/4 NE 1/4 NW 1/4

Forward the white, blue and pink copies to the Department of Health and Environment

Form WWC-5