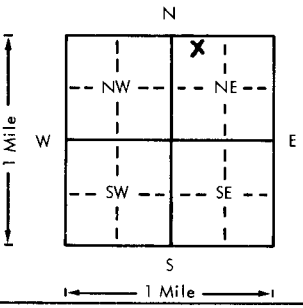


USE TYPEWRITER OR BALL POINT PEN-PRESS FIRMLY, PRINT CLEARLY.

WATER WELL RECORD  
KSA 82a-1201-1215

Kansas Department of Health and Environment- Division of Environment  
(Water well Contractors)  
Topeka, Kansas 66620

ABB

1. Location of well:		County <b>Norton</b>	Fraction <b>NW 1/4 NW 1/4 NE 1/4</b>	Section number <b>1</b>	Township number T <b>3</b> S R <b>23</b>	Range number <b>23</b>
2. Distance and direction from nearest town or city: <b>1 MILE EAST 1 MILE SOUTH</b> Street address of well location if in city: <b>OF Norton</b>				3. Owner of well: <b>LARRY ENFIELD</b> R.R. or street: City, state, zip code: <b>Norton KS 67654</b>		
4. Locate with "X" in section below: Sketch map:  <b>NEW HOME SITE</b> <b>NO CONSTRUCTION STARTED.</b>				6. Bore hole dia. <u>9</u> in. Completion date _____ Well depth <u>25</u> ft. <b>3-24-78</b>		
5. Type and color of material				From	To	7. <input checked="" type="checkbox"/> Cable tool <input checked="" type="checkbox"/> Rotary <input type="checkbox"/> Driven <input type="checkbox"/> Dug <input type="checkbox"/> Hollow rod <input type="checkbox"/> Jetted <input type="checkbox"/> Bored <input type="checkbox"/> Reverse rotary
<b>CLAY BLACK</b>				<b>0</b>	<b>35</b>	8. Use: <input checked="" type="checkbox"/> Domestic <input type="checkbox"/> Public supply <input type="checkbox"/> Industry <input type="checkbox"/> Irrigation <input type="checkbox"/> Air conditioning <input type="checkbox"/> Stock <input type="checkbox"/> Lawn <input type="checkbox"/> Oil field water <input type="checkbox"/> Other
<b>CLAY BLUE.</b>				<b>35</b>	<b>55</b>	9. Casing: Material _____ Height <u>Above</u> or below Threaded _____ Welded _____ Surface <u>12</u> in. RMP _____ PVC <input checked="" type="checkbox"/> Weight <u>275</u> lbs./ft. Dia. <u>5</u> in. to <u>55</u> ft. depth Wall Thickness: inches or Dia. _____ in. to _____ ft. depth Gauge No. <u>258</u>
<b>SAND &amp; GRAVEL with FLINT ROCK</b>				<b>55</b>	<b>72</b>	10. Screen: Manufacturer's name <b>MODERN PIPES INC</b> Type <b>PVC</b> Dia. <b>5"</b> Slot/Screen <b>.070</b> Length <b>20"</b> Set between <b>55</b> ft. and <b>75</b> ft. _____ ft. and _____ ft. Gravel pack? <input checked="" type="checkbox"/> YES Size range of material <b>1/2-1/4</b>
<b>SHALE GRAY TURNING TO BLUE.</b>				<b>72</b>	<b>75</b>	11. Static water level: _____ mo./day/yr. <b>37</b> ft. below land surface Date <b>3-24-78</b>
<b>BROCK 72'</b>						12. Pumping level below land surfaces: _____ ft. after _____ hrs. pumping _____ g.p.m. _____ ft. after _____ hrs. pumping _____ g.p.m. Estimated maximum yield <b>30</b> g.p.m.
<b>37</b>						13. Water sample submitted: _____ mo./day/yr. <input type="checkbox"/> Yes <input checked="" type="checkbox"/> No Date _____
<b>35' sat thick</b>						14. Well head completion: <input checked="" type="checkbox"/> Pitless adapter <u>12</u> inches above grade
<b>1" Og</b>						15. Well grouted? <input checked="" type="checkbox"/> YES With: _____ Neat cement _____ Bentonite <input checked="" type="checkbox"/> Concrete Depth: From <u>5</u> ft. to <u>15</u> ft.
						16. Nearest source of possible contamination: ft. <u>200</u> Direction <u>South</u> Type <u>SEWER</u> Well disinfected upon completion? <input checked="" type="checkbox"/> Yes <input type="checkbox"/> No
						17. Pump: _____ Not installed Manufacturer's name <u>BERMATOR</u> Model number <u>SD12</u> HP <u>1/2</u> Volts <u>230</u> Length of drop pipe <u>63</u> ft. capacity <u>12</u> g.p.m. Type: <input checked="" type="checkbox"/> Submersible _____ Turbine <input type="checkbox"/> Jet _____ Reciprocating <input type="checkbox"/> Centrifugal _____ Other
(Use a second sheet if needed)						20. Water well contractor's certification: This well was drilled under my jurisdiction and this report is true to the best of my knowledge and belief. <b>FAWCETT Drilling 167</b> Business name License No. Address <u>Box 149, Norton KS</u> Signed <u>[Signature]</u> Date <u>4-12-78</u> Authorized representative
18. Elevation:	19. Remarks: <b>SEND MORE 2240</b> <b>www-5's 21381</b>					
Topography: <input type="checkbox"/> Hill <input type="checkbox"/> Slope <input type="checkbox"/> Upland <input checked="" type="checkbox"/> Valley						

T  
W  
R  
3  
3  
1  
1/4  
1/4  
1/4  
NE