USE TYPEWRITER OR BALL POINT PEN-PRESS FIRMLY, PRINT CLEARLY.

T	R	EW	sec 1/4	1/4	1/4	No.				

WATER WELL RECORD
KSA 82a-1201-1215

Kansas State Dept. Of Health
(Water Well Contractors)
Forbes-Bldg. 740
Topeka, Kansas 66620

1 Location of well:	County	Township name	Fraction	Section number	Town number	Range number
	Norton	Center	SW of NE¼	2	3	23W

Distance and direction from nearest town or city: 1 mile east of Norton, Kansas

Street address of well location if in city:

3 Owner of well: Stephen Peak
Address: RFD #3 Norton, Kansas 67654

Locate with "X" in section below:

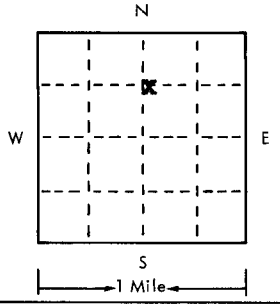

Sketch map:

2 Type and color of material	From	To
Black top soil	0	20
Yellow clay	20	33
Black sandy clay	33	40
Sand	40	54
Blue shale	54	55
30 in 20' solid		
in Alluvium		
(use a second sheet if needed)		

4 Well depth: 55 ft. Date of completion 8/22/75
Well diameter 9 in.

5 ☐ Cable tool ☒ Rotary ☐ Driven ☐ Dug ☐ Hollow rod ☐ Jetted ☐ Bored ☐ Reverse rotary

6 Use: ☒ Domestic ☐ Public supply ☐ Industry ☐ Irrigation ☐ Air conditioning ☐ Commercial ☐ Test well ☐

7 Casing: Material RMP Height: (above) below
Threaded ☐ Welded ☐ Surface 12 in.
Diam. Weight 278 lbs./ft 100
5 in. to 35 ft. depth Drive shoe? ☐ Yes ☒ No
in. to ft. depth

8 Screen:
Manufacturer Modern Pipe Inc.
Type PVC Dia. 5"
Slot/gauze Slot Length 20'
Set between 35 ft. and 55 ft.
Fittings:
Gravel pack ☒ Yes ☐ No Size range of material 1/8

9 Static water level: 34' ft. below land surface Date

10 Pumping level below land surfaces: 40' ft. after 2 hrs. pumping 20 g.p.m.
ft. after hrs. pumping g.p.m.
Estimated maximum yield 20 g.p.m.

11 Water sample submitted: ☐ Yes ☒ No Date

12 Well head completion: ☒ Pitless adapter 12 ☐ Inches above grade

13 Well grouted? ☒ Yes ☐ No
☒ Neat cement ☐ Bentonite ☐
Depth: From 4 ft. to 15 ft.

14 Nearest source of possible contamination: House
ft 2000' Direction South west type Sewer
Well disinfected upon completion? ☒ Yes ☐ No

15 Pump: ☐ Not installed
Manufacturer's name Aermotor
Model number SD-12 HP ½ Vol 230
Length of drop pipe 51 ft. capacity 12 g.m.p.
Type:
☒ Submersible ☐ Turbine
☐ Jet ☐ Reciprocating
☐ Certrifugal ☐ Other

16 Remarks: elevation 2230 (TOPO)

Topography:
☐ Hill
☒ Slope Second Bottom
☐ Upland
☐ Valley

17 Water well contractor's certification:
This well was drilled under my jurisdiction and this report is true to the best of my knowledge and belief.
John R Fawcett & Son 167
Business name License No.
Address Box 149 Norton, Kansas
Signed [signature] Date 9/11/75
Authorized representative

Forward the white, blue and pink copies to the Kansas State Dept. Of Health.

Form WWC-5