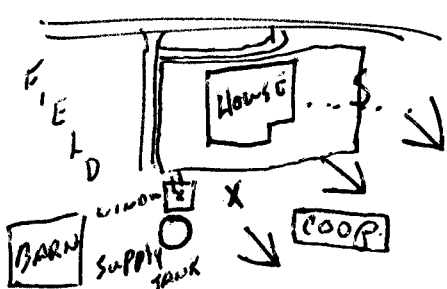


USE TYPEWRITER OR BALL POINT PEN-PRESS FIRMLY, PRINT CLEARLY.

WATER WELL RECORD
KSA 82a-1201-1215

Kansas Department of Health and Environment-Division of Environment (Water well Contractors) Topeka, Kansas 66620

AAA

1. Location of well: County: <u>Norton</u>		Fraction: <u>NE 1/4 NE 1/4 NE 1/4</u>		Section number: <u>2</u>	Township number: T <u>3</u> S	Range number: R <u>23</u> E/W
2. Distance and direction from nearest town or city: <u>1 mile East of Norton Ks.</u> Street address of well location if in city:			3. Owner of well: <u>John Little</u> R.R. or street: <u>331 W. Main</u> City, state, zip code: <u>Norton Ks 67654</u>			
4. Locate with "X" in section below: N W E S 1 Mile			Sketch map: <u>N</u> 		6. Bore hole dia. <u>9</u> in. Completion date: <u>8/05/77</u> Well depth: <u>70</u> ft.	
5. Type and color of material			From		To	
			CLAY BLACK		0 8	
			CLAY TAN		8 33	
			CLAY SANDY		33 47	
			SAND -		47 68	
			CLAY - SHALE BLUE (oil)		68 70	
			BROCK 70' <u>36</u>			
			<u>34' sat-thick</u>			
			<u>in Og</u>			
					10. Screen: Manufacturer's name: <u>Madigan Pipes Inc.</u> Type: <u>PVC</u> Dia. <u>5"</u> Slot/auze: <u>0.32</u> Length: <u>20'</u> Set between <u>50</u> ft. and <u>70</u> ft. Gravel pack? <u>yes</u> Size range of material: <u>1/4-1/2"</u>	
					11. Static water level: <u>36</u> ft. below land surface Date: <u>8-5-77</u>	
					12. Pumping level below land surfaces: ____ ft. after ____ hrs. pumping ____ g.p.m. ____ ft. after ____ hrs. pumping ____ g.p.m. Estimated maximum yield: <u>30</u> g.p.m.	
					13. Water sample submitted: <u>X</u> Yes <u>No</u> Date: _____	
					14. Well head completion: <u>X</u> Pitless adapter <u>12</u> inches above grade	
					15. Well grouted? _____ With: _____ Neat cement _____ Bentonite <u>X</u> Concrete Depth: From <u>5</u> ft. to <u>15</u> ft.	
					16. Nearest source of possible contamination: <u>100</u> ft. Direction: <u>NE</u> Type: <u>SEWER</u> Well disinfected upon completion? <u>X</u> Yes _____ No	
					17. Pump: Not installed Manufacturer's name: <u>Aeromotor</u> Model number: <u>5012-50</u> HP: <u>1/2</u> Volts: <u>230</u> Length of drop pipe: <u>59</u> ft. capacity: <u>12</u> g.p.m. Type: <u>X</u> Submersible _____ Turbine _____ Jet _____ Reciprocating _____ Centrifugal _____ Other	
18. Elevation:			19. Remarks: <u>2248</u> <u>211</u>			
Topography: <u>X</u> Hill <u>X</u> Slope ____ Upland ____ Valley			20. Water well contractor's certification: This well was drilled under my jurisdiction and this report is true to the best of my knowledge and belief. <u>FAWCETT & SON</u> <u>167</u> Business name License No. Address: <u>Box 149, Norton Ks</u> Signed: <u>[Signature]</u> Date: <u>8-29-77</u> Authorized representative			

1-16
R
2
NE NE NE
1/4 1/4 1/4