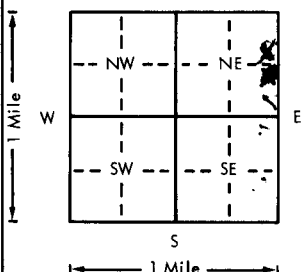
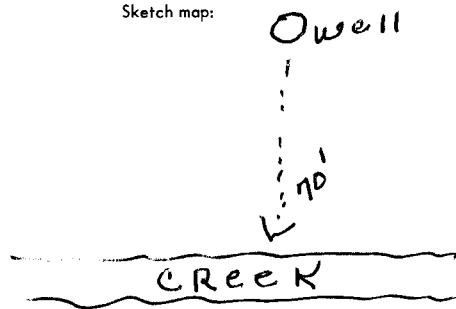


USE TYPEWRITER OR BALL
POINT PEN-PRESS FIRMLY,
PRINT CLEARLY.

WATER WELL RECORD
KSA 82a-1201-1215

Kansas Department of Health and
Environment-Division of Environment
(Water well Contractors)
Topeka, Kansas 66620

1. Location of well:		County NORTON	Fraction SE 1/4 NE 1/4 NE 1/4	Section number 3	Township number T 3 S	Range number R 23 E/W
2. Distance and direction from nearest town or city: Street address of well location if in city:		1/2 mile south & west of NORTON, KS		3. Owner of well: R., R. or street: City, state, zip code:		
4. Locate with "X" in section below:		Sketch map:		6. Bore hole dia. 9 in. Completion date 7/6/77 Well depth 43 ft.		
				7. <input checked="" type="checkbox"/> Cable tool <input checked="" type="checkbox"/> Rotary <input type="checkbox"/> Driven <input type="checkbox"/> Dug <input type="checkbox"/> Hollow rod <input type="checkbox"/> Jetted <input type="checkbox"/> Bored <input type="checkbox"/> Reverse rotary		
5. Type and color of material		From		To		8. Use: <input type="checkbox"/> Domestic <input type="checkbox"/> Public supply <input type="checkbox"/> Industry <input checked="" type="checkbox"/> Irrigation <input type="checkbox"/> Air conditioning <input type="checkbox"/> Stock <input type="checkbox"/> Lawn <input type="checkbox"/> Oil field water <input type="checkbox"/> Other
CLAY		0		14		9. Casing: Material PLAST Height: Above or below Threaded <input type="checkbox"/> Welded gld Surface 24 in. RMP <input checked="" type="checkbox"/> PVC Weight 320 lbs./ft. Dia. 6 in. to 43 ft. depth Wall Thickness: inches or Dia. 6 in. to 43 ft. depth gage No. 320
SAND		14		16		10. Screen: Manufacturer's name JESS & Lowell Type PLASTIC Dia. 6" Slot/gauze 1/4 Length 10' Set between 33 ft. and 43 ft. Gravel pack? yes Size range of material 1/4 - 5/8
CLAY		16		27		11. Static water level: 23 ft. below land surface Date 7/6/77 mo./day/yr.
SAND & mud STRIPS		27		42		12. Pumping level below land surfaces: ft. after 38 hrs. pumping 150 g.p.m. ft. after 3 hrs. pumping 150 g.p.m. Estimated maximum yield 150 g.p.m.
Shale		42		43		13. Water sample submitted: 1 mo./day/yr. Yes <input checked="" type="checkbox"/> No <input type="checkbox"/> Date
BROCK 42'						<input checked="" type="checkbox"/> Well head completion: NOT DONE Pitless adapter <input type="checkbox"/> Inches above grade
23'						15. Well grouted? yes With: <input checked="" type="checkbox"/> Neat cement <input type="checkbox"/> Bentonite <input type="checkbox"/> Concrete Depth: From 0 ft. to 10 ft.
19' sand						16. Nearest source of possible contamination: ft. 70' Direction South Type CRICK Well disinfected upon completion? <input checked="" type="checkbox"/> Yes <input type="checkbox"/> No
Alluvium						17. Pump: Manufacturer's name Gould Not installed Model number 4H 6474272 HP 7 1/2 Volts 240 Length of drop pipe 35 ft. capacity 150 g.p.m. Type: <input checked="" type="checkbox"/> Submersible <input type="checkbox"/> Turbine <input type="checkbox"/> Jet <input type="checkbox"/> Reciprocating <input type="checkbox"/> Centrifugal <input type="checkbox"/> Other
2247						20. Water well contractor's certification: This well was drilled under my jurisdiction and this report is true to the best of my knowledge and belief. DEL Drilling Co 303 Business name 11101 318 License No. Address Hill City, KS. 67642 Signed Allen G. Jones Date 7-24 Authorized representative
18. Elevation:		19. Remarks:				
Topography: <input checked="" type="checkbox"/> Hill <input checked="" type="checkbox"/> Slope <input type="checkbox"/> Upland <input type="checkbox"/> Valley		CONCRETE SLAB TO BE INSTALLED BY CUSTOMER AT GROUND SURFACE.				