USE TYPEWRITER OR BALL POINT PEN-PRESS FIRMLY, PRINT CLEARLY.

T	R	EW	sec	1/4	1/4	1/4	No.

WATER WELL RECORD
KSA 82a-1201-1215

Kansas State Dept. Of Health
(Water Well Contractors)
Forbes-Bldg. 740
Topeka, Kansas 66620

1 Location of well:	County	Township name	Fraction	Section number	Town number	Range number
	NORTON	CENTER	SE 1/4 of NW 1/4	4	3	23 W

Distance and direction from nearest town or city: 1 1/2 miles south west of NORTON

Street address of well location if in city:

3 Owner of well: LEO DERKS

Address: RR #3 NORTON KS. 67654

Locate with "X" in section below:

Sketch map:

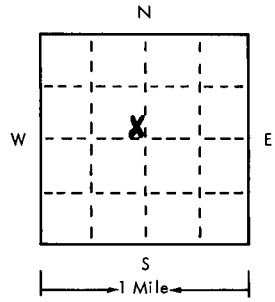

4 Well depth: 70' ft. Date of completion 6/12 75
Well diameter 9" in.

5 ☐ Cable tool ☒ Rotary ☐ Driven ☐ Dug
☐ Hollow rod ☐ Jetted ☐ Bored ☐ Reverse rotary

6 Use: ☒ Domestic ☐ Public supply ☐ Industry
☐ Irrigation ☐ Air conditioning ☐ Commercial
☐ Test well ☐

7 Casing: Material RMP Height: above ~~below~~
Threaded ☐ Welded ☐ Surface 12 in.
Diam. 5 in. to 50' ft. depth Weight 278 lbs./ft. 100'
___ in. to ___ ft. depth Drive shoe? ☐ Yes ☒ No

2 Type and color of material	From	To
BLACK Top soil	0	21
yellow CLAY	21	40
FINE SAND	40	55
SAND & GRAVEL	55	67
GRAY SHALE	67	70
67		
42		
1hr 25' sa Hole		
in Alluvium		
(use a second sheet if needed)		

8 Screen:
Manufacturer MODERN PIPES INC
Type PVC Dia. 5"
Slot ~~gauze~~ .032 Length 20'
Set between 50 ft. and 70 ft.
Fittings:
Gravel pack ☒ Yes ☐ No Size range of material 1/8"

9 Static water level:
42' ft. below land surface Date 6/12/75

10 Pumping level below land surfaces:
N/A ft. after ___ hrs. pumping ___ g.p.m.
ft. after ___ hrs. pumping ___ g.p.m.
Estimated maximum yield 30 g.p.m.

11 Water sample submitted:
☐ Yes ☒ No Date ___

12 Well head completion: 12
☒ Pitless adapter ☒ Inches above grade

13 Well grouted? ☒ Yes ☐ No
☐ Neat cement ☒ Bentonite ☐
Depth: From 35 ft. to SURFACE

14 Nearest source of possible contamination:
ft. 100' Direction South Type SEWER
Well disinfected upon completion? ☐ Yes ☒ No

15 Pump: ☐ Not installed
Manufacturer's name AERMOTOR
Model number SD-12-50 HP 1/2 Volts 115
Length of drop pipe 50' ft. capacity 12 g.m.p.
Type:
☒ Submersible ☐ Turbine
☐ Jet ☐ Reciprocating
☐ Certrifugal ☐ Other

16 Remarks: elevation 2090 (TOPO)

Topography:
☐ Hill
☐ Slope
☐ Upland
☒ Valley

17 Water well contractor's certification:
This well was drilled under my jurisdiction and this report is true to the best of my knowledge and belief.
FAWCETT & SON DRL. 167
Business name License No.
Address Box 149 NORTON KS
Signed [signature] Date 6/13/75
Authorized representative

Forward the white, blue and pink copies to the Kansas State Dept. Of Health.

Form WWC-5