


1 LOCATION OF WATER WELL: County: Norton Fraction: SW 1/4 NE 1/4 SW 1/4 Section Number: 19 Township Number: T 3 S Range Number: R 23 EW

Distance and direction from nearest town or city street address of well if located within city? Norton 4 miles S on Hwy 283 + 4 ml. West From the south edge of

2 WATER WELL OWNER: Dwight Sprigg
 RR#, St. Address, Box #: Rt. 2
 City, State, ZIP Code: Norton, Kansas 67654
 Board of Agriculture, Division of Water Resources
 Application Number:

3 LOCATE WELL'S LOCATION WITH AN "X" IN SECTION BOX:

4 DEPTH OF COMPLETED WELL: 99 ft. ELEVATION:

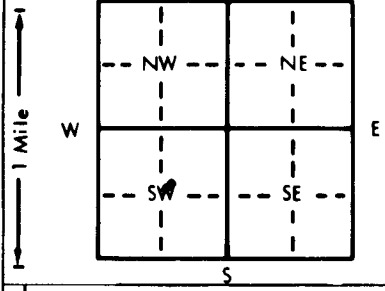

Depth(s) Groundwater Encountered 1. 36 1/2 ft. 2. 99 ft. 3. 99 ft.
 WELL'S STATIC WATER LEVEL 36 1/2 ft. below land surface measured on mo/day/yr
 Pump test data: Well water was 9 ft. after 8 hours pumping 99 gpm
 Est. Yield 99 gpm; Well water was 9 ft. after 8 hours pumping 99 gpm
 Bore Hole Diameter: 9 in. to 20 ft., and 8 in. to 99 ft.
 WELL WATER TO BE USED AS:
 1 Domestic 3 Feedlot 6 Oil field water supply 9 Dewatering 12 Other (Specify below)
 2 Irrigation 4 Industrial 7 Lawn and garden only 10 Monitoring well
 Was a chemical/bacteriological sample submitted to Department? Yes No If yes, mo/day/yr sample was submitted
 Water Well Disinfected? Yes No

5 TYPE OF BLANK CASING USED:
 1 Steel 3 RMP (SR) 5 Wrought iron 8 Concrete tile CASING JOINTS: Glued No Clamped
 2 PVC 4 ABS 6 Asbestos-Cement 9 Other (specify below) Welded
 7 Fiberglass Threaded

Blank casing diameter 5 in. to 79 ft., Dia. 79 in. to 99 ft., Dia. 99 in. to 99 ft.
 Casing height above land surface 12 in., weight 50R21 lbs./ft. Wall thickness or gauge No. 50R21

TYPE OF SCREEN OR PERFORATION MATERIAL:
 1 Steel 3 Stainless steel 5 Fiberglass 8 RMP (SR) 10 Asbestos-cement
 2 Brass 4 Galvanized steel 6 Concrete tile 9 ABS 12 None used (open hole)

SCREEN OR PERFORATION OPENINGS ARE:
 1 Continuous slot 3 Mill slot 5 Gauzed wrapped 8 Saw cut 11 None (open hole)
 2 Louvered shutter 4 Key punched 6 Wire wrapped 9 Drilled holes
 7 Torch cut 10 Other (specify)

SCREEN-PERFORATED INTERVALS: From 79 ft. to 99 ft., From 99 ft. to 99 ft.

GRAVEL PACK INTERVALS: From 20 ft. to 99 ft., From 99 ft. to 99 ft.

6 GROUT MATERIAL: 1 Neat cement 2 Cement grout 3 Bentonite 4 Other

Grout Intervals: From 0 ft. to 20 ft., From 20 ft. to 99 ft., From 99 ft. to 99 ft.

What is the nearest source of possible contamination:
 1 Septic tank 4 Lateral lines 7 Pit privy 10 Livestock pens 14 Abandoned water well
 2 Sewer lines 5 Cess pool 8 Sewage lagoon 11 Fuel storage 15 Oil well/Gas well
 3 Watertight sewer lines 6 Seepage pit 9 Feedyard 12 Fertilizer storage 16 Other (specify below)

Direction from well? Nothing middle Pasture
 How many feet? Nothing middle Pasture

Direction from well? Nothing middle Pasture

FROM	TO	LITHOLOGIC LOG	FROM	TO	PLUGGING INTERVALS
0	12	Top Soil of clay			
12	20	Sand & dirt			
20	36	Black dirt			
36	60	Sandstone & dirt mix			
60	99	Sandstone & finesand			

7 CONTRACTOR'S OR LANDOWNER'S CERTIFICATION: This water well was (1) constructed, (2) reconstructed, or (3) plugged under my jurisdiction and was completed on (mo/day/year) 4-7-91 and this record is true to the best of my knowledge and belief. Kansas Water Well Contractor's License No. 428 This Water Well Record was completed on (mo/day/yr) 7-4-91 under the business name of STALDER DRILLING by (signature) Jerry L. Stalder