

USE TYPEWRITER OR BALL POINT PEN-PRESS FIRMLY, PRINT CLEARLY.

WATER WELL RECORD
KSA 82a-1201-1215


Kansas Department of Health and Environment-Division of Environment (Water well Contractors) Topeka, Kansas 66620

BCC

Norton

1. Location of well: County Norton Fraction SW NW NW 1/4 1/4 1/4 Section number 23 Township number T 3 S R 23 W E/W

2. Distance and direction from nearest town or city: 4 mi So of Norton Kansas 3. Owner of well: Elmon Heaton
Street address of well location if in city: Norton Kansas 67654 R.R. or street:
City, state, zip code: Norton Kansas 67654

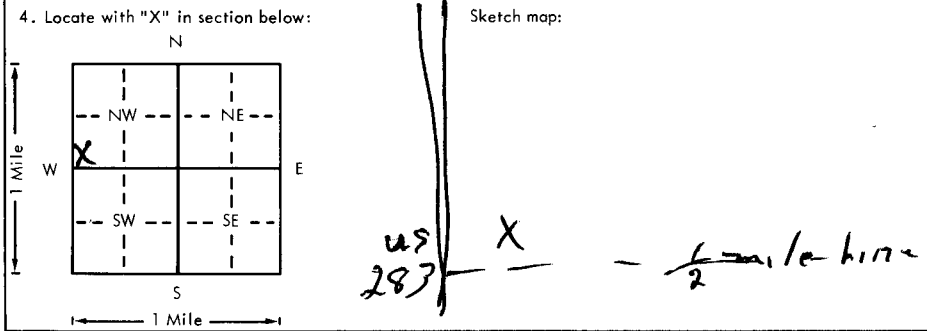

6. Bore hole dia. 9 in. Completion date 7/20/79
Well depth 184 ft.
7. Cable tool Rotary Driven Dug
 Hollow rod Jetted Bored Reverse rotary
8. Use: Domestic Public supply Industry
 Irrigation Air conditioning Stock
 Lawn Oil field water Other
9. Casing: Material Plastic Weight: Above or below
Threaded Welded Surface 14 in.
RMP PVC Weight 2.75 lbs./ft.
Dia. 5 in. to 164 ft. depth Wall Thickness: inches or
Dia. 5 in. to 164 ft. depth gage No. 250

5. Type and color of material	From	To
<u>0-30 clay</u>	<u>0</u>	<u>30</u>
<u>Lime Rock & clay</u>	<u>30</u>	<u>156</u>
<u>V F Sand with white lime</u>	<u>156</u>	<u>184</u>
<u>BROCK ?</u>		

10. Screen: Manufacturer's name Modern Pipe INC
Type PVC Dia. 5
Slot/ 0.032 Length 20
Set between 164 ft. and 184 ft.
ft. and 184 ft.
Gravel pack? Yes Size range of material 1/4 - 1/2
11. Static water level: 167 ft. below land surface Date 8/12/79 mo./day/yr.
12. Pumping level below land surfaces:
ft. after hrs. pumping g.p.m.
ft. after hrs. pumping g.p.m.
Estimated maximum yield 6 g.p.m.
13. Water sample submitted: mo./day/yr.
 Yes No Date
14. Well head completion: Cement Platform
 Pitless adapter 14 Inches above grade
15. Well grouted?
With: Neat cement Bentonite Concrete
Depth: From 0 ft. to 16 ft.
16. Nearest source of possible contamination: None
ft. Direction Type
Well disinfected upon completion? Yes No
17. Pump: Not installed
Manufacturer's name Challenge windmill
Model number HP Volts
Length of drop pipe 174 ft. capacity 3 g.p.m.
Type:
 Submersible Turbine
 Jet Reciprocating
 Centrifugal Other

18. Elevation: 3442
19. Remarks:
Topography:
 Hill
 Slope
 Upland
 Valley

20. Water well contractor's certification:
This well was drilled under my jurisdiction and this report is true to the best of my knowledge and belief.
Fawcett & Son Drlg 167
Business name Norton Kansas License No.
Address
Signed John R. Fawcett Date 8/27/79
Authorized representative

T
3
R
23
W
23
Sec
1/4
1/4
1/4