

#19


WATER WELL PLUGGING RECORD Form WWC-5P KSA 82a-1212 ID NO.

1 LOCATION OF WATER WELL: Fraction NW 1/4 SW 1/4 NW 1/4 1/4 Section Number 3 Township Number T 3 S Range Number 23 E W
County: Norton

Street/Rural Address of Well Location; if unknown, distance & direction from nearest town or intersection: If at owner's address, check here
3319' North and 4559' West of Southeast Corner

Global Positioning Systems (GPS) information:
Latitude: N 39 49 18.6 (in decimal degrees)
Longitude: W 099 54 21.1 (in decimal degrees)
Elevation: _____
Datum: WGS84, NAD83, NAD27
Collection Method:
 GPS unit (Make/Model: _____)
 Digital Map/Photo, Topographic Map, Land Survey
Est. Accuracy: < 3 m, 3-5 m, 5-15 m, > 15 m

2 WATER WELL OWNER: City of Norton
RR#, St. Address, Box #: 301 East Washington
City, State ZIP Code: Norton, KS 67654

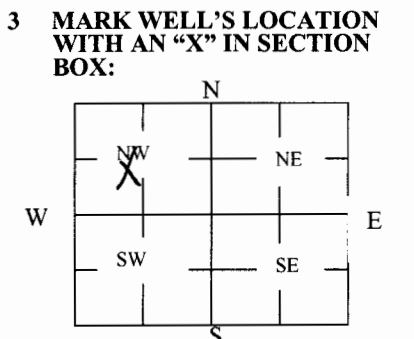

4 DEPTH OF WELL 66 ft.
WELL'S STATIC WATER LEVEL 38 ft
WELL WAS USED AS:
 Domestic Public Water Supply Dewatering
 Irrigation Oil Field Water Supply Monitoring
 Feedlot Domestic (Lawn & Garden) Injection Well
 Industrial Air Conditioning Other _____
Was a chemical/bacteriological sample submitted to Department? Yes No

5 TYPE OF BLANK CASING USED:
 Steel RMP (SR) Wrought Fiberglass Other (Specify below) _____
 PVC ABS Asbestos-Cement Concrete Tile
Blank casing diameter 12 in. Was casing pulled? Yes No If yes, how much _____
Casing height above or (below) land surface 60 in.

6 GROUT PLUG MATERIAL: Neat cement Cement grout Bentonite Other _____
Grout Plug Intervals: From 44 ft. to 15 ft., From 15 ft. to 5 ft., From _____ to _____ ft.
What is the nearest source of possible contamination:
 Septic tank Seepage pit Fuel Storage Other (specify below) _____
 Sewer lines Pit privy Fertilizer storage Public Water Supply
 Watertight sewer lines Sewage lagoon Insecticide storage
 Lateral lines Feedyard Abandoned water well Direction from well? Northwest
 Cess pool Livestock pens Oil well/Gas well How many feet? 30'

FROM	TO	PLUGGING MATERIALS	FROM	TO	PLUGGING MATERIALS
66	44	Chlorinated Gravel			
44	15	Bentonite Chips			
15	5	Cement Grout			

7 CONTRACTOR'S OR LANDOWNER'S CERTIFICATION: This water well was plugged under my jurisdiction and was completed on (mo/day/year) 01/08/10 and this record is true to the best of my knowledge and belief. Kansas Water Well Contractor's License No. 748. This Water Well Record was completed on (mo/day/year) 03/03/10 under the business name of Downey Drilling Inc. by (signature) [Signature]

INSTRUCTIONS: Use typewriter or ballpoint pen. Please press firmly and print clearly. Please fill in blanks, underline or circle the correct answers. Send top three copies to Kansas Department of Health and Environment, Bureau of Water, Geology Section, 1000 SW Jackson St., Ste. 420, Topeka, Kansas 66612-1367. Telephone: 785/296-5524. Send one to Water Well Owner and retain one for your records. Visit us at <http://www.kdheks.gov/waterwell/index.html>.

Check one: White Copy Blue Copy Pink Copy