


**1 LOCATION OF WATER WELL:**  
 County: Norton Fraction E 1/4 SE 1/4 SW 1/4 Section Number 15 Township Number 3 Range Number 23 **EW**  
 Distance and direction from nearest town or city street address of well if located within city? \_\_\_\_\_

**2 WATER WELL OWNER:** Calvin + Tim Gill  
 RR#, St. Address, Box #: 508 E Wilton  
 City, State ZIP Code: Norton KS 67654  
**Global Positioning Systems** (decimal degrees, min. of 4 digits)  
 Latitude: \_\_\_\_\_  
 Longitude: \_\_\_\_\_  
 Elevation: \_\_\_\_\_  
 Datum: \_\_\_\_\_  
 Data Collection Method: \_\_\_\_\_

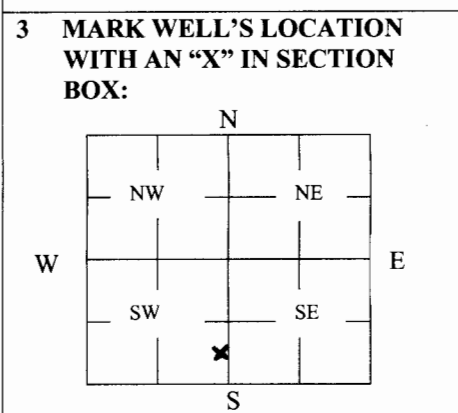

**4 DEPTH OF WELL** 170 ft.  
**WELL'S STATIC WATER LEVEL** 160 ft.  
**WELL WAS USED AS:**  
 1 Domestic                      5 Public Water Supply                      9 Dewatering  
 2 Irrigation                      6 Oil Field Water Supply                      10 Monitoring  
 3 Feedlot                          7 Domestic (Lawn & Garden)                      11 Injection Well  
 4 Industrial                      8 Air Conditioning                          12 Other livestock  
 Was a chemical/bacteriological sample submitted to Department? Yes \_\_\_\_\_ No X

**5 TYPE OF BLANK CASING USED:**  
 Steel      3 RMP (SR)      5 Wrought                      7 Fiberglass                      9 Other (Specify below) \_\_\_\_\_  
 2 PVC      4 ABS                      6 Asbestos-Cement                      8 Concrete Tile \_\_\_\_\_  
 Blank casing diameter \_\_\_\_\_ in. Was casing pulled? Yes \_\_\_\_\_ No X If yes, how much \_\_\_\_\_  
 Casing height ~~above~~ or below land surface 36 in. below

**6 GROUT PLUG MATERIAL:**      1 Neat cement      2 Cement grout      **3 Bentonite**      4 Other \_\_\_\_\_  
 Grout Plug Intervals: From 6 ft. to 3 ft., From \_\_\_\_\_ ft. to \_\_\_\_\_ ft., From \_\_\_\_\_ to \_\_\_\_\_ ft.  
 What is the nearest source of possible contamination:  
 1 Septic tank                      6 Seepage pit                      11 Fuel Storage                      16 Other (specify below) overflow pit  
 2 Sewer lines                      7 Pit privy                          12 Fertilizer storage  
 3 Watertight sewer lines      8 Sewage lagoon                      13 Insecticide storage  
 4 Lateral lines                      9 Feedyard                          14 Abandoned water well      Direction from well? east  
 5 Cess pool                          10 Livestock pens                      15 Oil well/Gas well              How many feet? 60'

FROM	TO	PLUGGING MATERIALS	FROM	TO	PLUGGING MATERIALS
170	160	Sand + gravel			
160	6	clays			
6	3	bentonite			

**7 CONTRACTOR'S OR LANDOWNER'S CERTIFICATION:** This water well was plugged under my jurisdiction and was completed on (mo/day/year) 11/7/15 and this record is true to the best of my knowledge and belief. Kansas Water Well Contractor's License No. \_\_\_\_\_ This Water Well Record was completed on (mo/day/year) 11/12/15 under the business name of Three G Drilling by (signature) Tim Gill

**INSTRUCTIONS:** Use typewriter or ballpoint pen. Please press firmly and print clearly. Please fill in blanks, underline or circle the correct answers. Send top three copies to Kansas Department of Health and Environment, Bureau of Water, Geology Section, 1000 SW Jackson St., Ste. 420, Topeka, Kansas 66612-1367. Telephone: 785/296-5522. Send one to Water Well Owner and retain one for your records. Visit us at <http://www.kdheks.gov/geo/waterwells>.