


1 LOCATION OF WATER WELL: County: Norton Fraction: SW 1/4 NW 1/4 NE 1/4 Section Number: 9 Township Number: T 3 S Range Number: R 24 E

Distance and direction from nearest town or city street address of well if located within city?

2 WATER WELL OWNER: Maddy Ranch Inc. 90 Steven Maddy  
 RR#, St. Address, Box #: Rt. 1 Box 173  
 City, State, ZIP Code: Almena, KS 67632  
 Board of Agriculture, Division of Water Resources  
 Application Number:

3 LOCATE WELL'S LOCATION WITH AN "X" IN SECTION BOX:

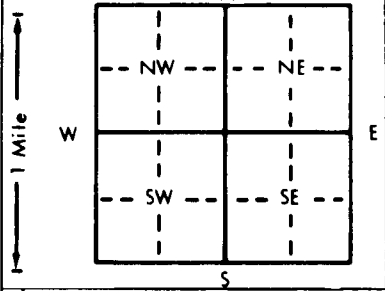

4 DEPTH OF COMPLETED WELL... 67 ft. ELEVATION:

Depth(s) Groundwater Encountered 1. .... ft. 2. .... ft. 3. .... ft.  
 WELL'S STATIC WATER LEVEL ... 32 ft. below land surface measured on mo/day/yr 9-26-95  
 Pump test data: Well water was .... ft. after .... hours pumping .... gpm  
 Est. Yield .... gpm: Well water was .... ft. after .... hours pumping .... gpm  
 Bore Hole Diameter... 8 3/4 in. to .... ft., and .... in. to .... ft.  
 WELL WATER TO BE USED AS: 5 Public water supply 8 Air conditioning 11 Injection well  
 ① Domestic 3 Feedlot 6 Oil field water supply 9 Dewatering 12 Other (Specify below)  
 2 Irrigation 4 Industrial 7 Lawn and garden only 10 Monitoring well  
 Was a chemical/bacteriological sample submitted to Department? Yes.....No...X...; If yes, mo/day/yr sample was submitted  
 Water Well Disinfected? Yes No

5 TYPE OF BLANK CASING USED: 1 Steel 3 RMP (SR) 5 Wrought iron 8 Concrete tile CASING JOINTS: Glued Clamped  
 2 PVC 4 ABS 6 Asbestos-Cement 9 Other (specify below) Welded  
 7 Fiberglass Threaded

Blank casing diameter ... 4" in. to .... ft., Dia ... in. to .... ft., Dia ... in. to .... ft.  
 Casing height above land surface ... 36 in., weight ... 160 lbs./ft. Wall thickness or gauge No. ... 173

TYPE OF SCREEN OR PERFORATION MATERIAL: 1 Steel 3 Stainless steel 5 Fiberglass 8 RMP (SR) 10 Asbestos-cement  
 2 Brass 4 Galvanized steel 6 Concrete tile 9 ABS 11 Other (specify)  
 12 None used (open hole)

SCREEN OR PERFORATION OPENINGS ARE: 1 Continuous slot 3 Mill slot 5 Gauzed wrapped 8 Saw cut 11 None (open hole)  
 2 Louvered shutter 4 Key punched 6 Wire wrapped 9 Drilled holes  
 7 Torch cut 10 Other (specify)

SCREEN-PERFORATED INTERVALS: From ... 67 ft. to ... 27 ft., From ... ft. to ... ft.  
 GRAVEL PACK INTERVALS: From ... 67 ft. to ... 10 ft., From ... ft. to ... ft.

6 GROUT MATERIAL: 1 Neat cement 2 Cement grout 3 Bentonite 4 Other ... Clay  
 Grout Intervals: From ... 10 ft. to ... 3 ft., From ... ft. to ... ft., From ... 3 ft. to ... 0 ft.

What is the nearest source of possible contamination:  
 1 Septic tank 4 Lateral lines 7 Pit privy 10 Livestock pens 14 Abandoned water well  
 2 Sewer lines 5 Cess pool 8 Sewage lagoon 11 Fuel storage 15 Oil well/Gas well  
 3 Watertight sewer lines 6 Seepage pit 9 Feedyard 12 Fertilizer storage 16 Other (specify below)  
 13 Insecticide storage

Direction from well? How many feet?

FROM	TO	LITHOLOGIC LOG	FROM	TO	PLUGGING INTERVALS
0	11	Soil & Clay			
11	18	Fine sand to small gravel			
18	26	Fine sand & sandy clay			
26	38	Clay & joint clay			
38	51	Fine to coarse sand			
51	58	Sandstone clay & lime			
58	65	P. sandstone, some sandy clay & lime			
65	67	Clay			
67		Flint Hard			

7 CONTRACTOR'S OR LANDOWNER'S CERTIFICATION: This water well was (1) constructed, (2) reconstructed, or (3) plugged under my jurisdiction and was completed on (mo/day/year) ... 9-26-95 ... and this record is true to the best of my knowledge and belief. Kansas Water Well Contractor's License No. ... 425 ... This Water Well Record was completed on (mo/day/yr) ... 9-27-95 ... under the business name of Burton Well Drilling, Inc by (signature) Jay Struth