


USE TYPEWRITER OR BALL POINT PEN-PRESS FIRMLY, PRINT CLEARLY.

WATER WELL RECORD
KSA 82a-1201-1215

Kansas Department of Health and Environment-Division of Environment
(Water well Contractors)
Topeka, Kansas 66620

Location of well: **NORTON** County **NORTON** Section number **4** Township number **3** Range number **24W**
 Action **SE 1/4 SW 1/4 SW 1/4** T **3** S R **24** **W**

Distance and direction from nearest town or city: **8 miles west** 3. Owner of well: **JIM MADDY**
 Street address of well location if in city: **1 mi. South of NORTON, KS.** R.R. or street: **R.R.**
 City, state, zip code: **AIMENA, KS, 67622**

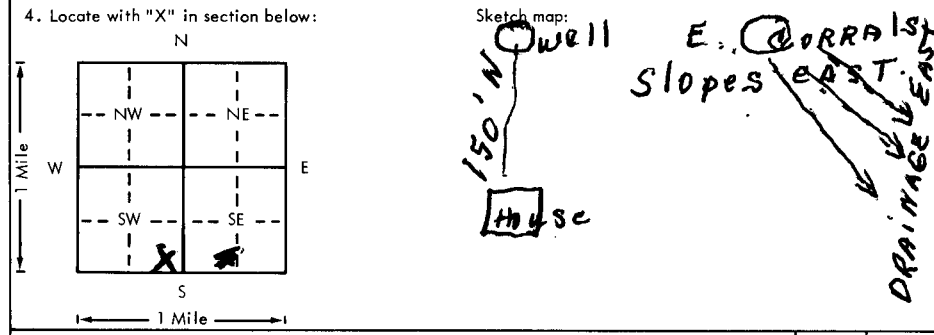

6. Bore hole dia. **9** in. Completion date **5/3/78**
 Well depth **130** ft.
 7. Cable tool Rotary Driven Dug
 Hollow rod Jetted Bored Reverse rotary
 8. Use: Domestic Public supply Industry
 Irrigation Air conditioning Stock
 Lawn Oil field water Other
 9. Casing: Material **PLST** Height: Above or below
 Threaded Welded **6 in** Surface **24** in.
 RMP PVC Weight lbs./ft.
 Dia. **5** in. to **130** ft. depth Wall Thickness: inches or
 Dia. in. to ft. depth gage No. **250**

5. Type and color of material	From	To
CLAY	0	88
SANDY CLAY & ROCK	88	96
SAND (FINE)	96	120
SAND & CLAY	120	142
YELLOW CLAY	142	147
SHALE	147	148
BRICK 142		
142		
60		
82' sat H		
in Og		

10. Screen: Manufacturer's name **GROWN LINE PLASTICS**
 Type **PLASTIC** Dia. **5"**
 Slot/gauze **1/16** Length **10'**
 Set between **120'** ft. and **130'** ft.
 Gravel pack? **yes** Size range of material **1/4 - 5/8"**
 11. Static water level: **60'** ft. below land surface Date **5/3/78**
 12. Pumping level below land surfaces: **NOT PUMPED**
 ___ ft. after ___ hrs. pumping ___ g.p.m.
 ___ ft. after ___ hrs. pumping ___ g.p.m.
 Estimated maximum yield ___ g.p.m.
 13. Water sample submitted: ___ mo./day/yr.
 Yes No Date ___
 14. Well head completion: **NOT DONE**
 ___ Pitless adapter ___ Inches above grade
 15. Well grouted? **yes**
 With: Neat cement Bentonite Concrete
 Depth: From **5** ft. to **15** ft.
 16. Nearest source of possible contamination: **UNKUSED**
 ft. **50** Direction **EAST** Type **CORRAIS**
 Well disinfected upon completion? Yes No
 17. Pump: Not installed
 Manufacturer's name ___ HP ___ Volts ___
 Model number ___ Length of drop pipe ___ ft. capacity ___ g.p.m.
 Type: ___ Submersible ___ Turbine
 ___ Jet ___ Reciprocating
 ___ Centrifugal ___ Other

18. Elevation: Topography: Hill ___ Slope ___ Upland ___ Valley ___
 19. Remarks: **Concrete slab to be installed by customer.**
 20. Water well contractor's certification: This well was drilled under my jurisdiction and this report is true to the best of my knowledge and belief.
D & L DRILLING CO 303
 Business name **303** License No. **303**
 Address **Box 368, Hill City, KS**
 Signed **Atlanta** Date **5/3/78**
 Authorized representative

3-22-78
 R
 4-SECSUSW
 1/4 1/4 1/4