USE TYPEWRITER OR BALL POINT PEN-PRESS FIRMLY, PRINT CLEARLY.

T	R	EW	sec 1/4	1/4	1/4 No.

WATER WELL RECORD
KSA 82a-1201-1215

Kansas State Dept. Of Health
(Water Well Contractors)
Forbes-Bldg. 740
Topeka, Kansas 66620

1 Location of well:	County	Township name	Fraction	Section number	Town number	Range number
	Norton	Leota	NW of NE ¼	2	3	24 W

Distance and direction from nearest town or city:
5 Miles west of Norton Kansas on 36 Highway
Street address of well location if in city:

3 Owner of well:
Jerry Rule
Address: Rt.3 Norton, Kansas 67654

Locate with "X" in section below: Sketch map:

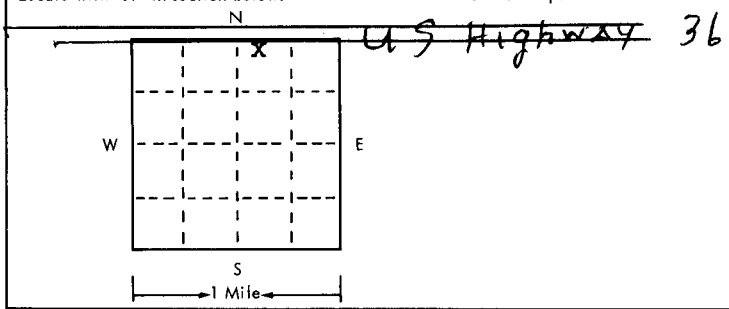

4 Well depth: 66 ft. Date of completion 8/18/75
Well diameter 9 in.

5 ☐ Cable tool ☒ Rotary ☐ Driven ☐ Dug
☐ Hollow rod ☐ Jetted ☐ Bored ☐ Reverse rotary

6 Use: ☒ Domestic ☐ Public supply ☐ Industry
☐ Irrigation ☐ Air conditioning ☐ Commercial
☐ Test well ☐

7 Casing: Material RMP Height: above/below
Threaded ☐ Welded ☐ Surface 12 in.
Diam. Weight 278 lbs./ft. 100
5 in. to 56 ft. depth Drive shoe? ☐ Yes ☒ No
___ in. to ___ ft. depth

2

Type and color of material	From	To
Yellow Clay	0	10
Fine sandy clay	10	55
White sandrock & fine sand with clay	55	65
Yellow & brown rock (very hard)	65	66
?		
(use a second sheet if needed)		

8 Screen:
Manufacturer Modern Pipe Inc.
Type PVC Dia. 5
Slot/gauze Slot Length 10'
Set between 56 ft. and 66 ft.
Fittings:
Gravel pack ☒ Yes ☐ No Size range of material 1/8

9 Static water level:
33 ft. below land surface Date 8/18/75

10 Pumping level below land surfaces:
65 ft. after 2 hrs. pumping 6 g.p.m.
___ ft. after ___ hrs. pumping ___ g.p.m.
Estimated maximum yield 6 g.p.m.

11 Water sample submitted:
☐ Yes ☒ No Date ___

12 Well head completion:
☒ Pitless adapter 12 ☐ Inches above grade

13 Well grouted? ☒ Yes ☐ No
☒ Neat cement ☐ Bentonite ☐ ___
Depth: From 4 ft. to 15 ft.

14 Nearest source of possible contamination:
ft. 200 Direction south Type Barn Lot
Well disinfected upon completion? ☒ Yes ☐ No

15 Pump: ☐ Not installed
Manufacturer's name Aermotor
Model number SD 5-33 HP 1/3 Volts 230
Length of drop pipe 62 ft. capacity 5 g.m.p.
Type:
☒ Submersible ☐ Turbine
☐ Jet ☐ Reciprocating
☐ Certrifugal ☐ Other

16 Remarks: elevation 2395 (TOPO)

Topography:
☐ Hill
☒ Slope
☐ Upland
☐ Valley

17 Water well contractor's certification:
This well was drilled under my jurisdiction and this report is true to the best of my knowledge and belief.
John R. Fawcett & Son 167
Business name License No.
Address Box 149 Norton, Kansas
Signed [signature] Date 9/11/75
Authorized representative

Forward the white, blue and pink copies to the Kansas State Dept. Of Health.

Form WWC-5