USE TYPEWRITER OR BALL POINT PEN-PRESS FIRMLY, PRINT CLEARLY.

ACR

WATER WELL RECORD
KSA 82a-1201-1215

Kansas Department of Health and Environment-Division of Environment
(Water well Contractors)
Topeka, Kansas 66620

1. Location of well:	County	Fraction	Section number	Township number	Range number
	Norton	NW 1/4 SW 1/4 NE 1/4	30	T 3 S	R 24 E/W

2. Distance and direction from nearest town or city: 6½ miles East of Clayton Ks
Street address of well location if in city:

3. Owner of well: Raymond Ankenman
R.R. or street:
City, state, zip code: Norton Ks 67654

4. Locate with "X" in section below:

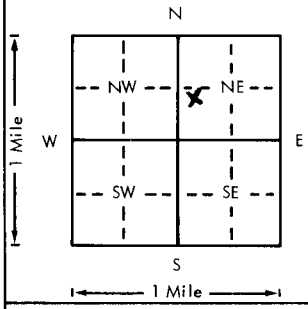

Sketch map:

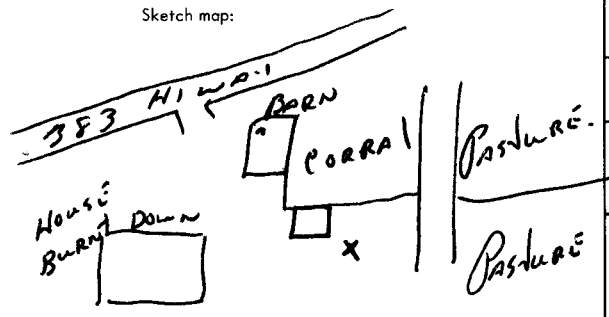

6. Bore hole dia. 9 in. Completion date 3-3-77 MNC
Well depth 70 ft.

7. __ Cable tool X Rotary __ Driven __ Dug
__ Hollow rod __ Jetted __ Bored __ Reverse rotary

8. Use: __ Domestic __ Public supply __ Industry
__ Irrigation __ Air conditioning X Stock
__ Lawn __ Oil field water __ Other

9. Casing: Material _____ Height: Above or below
Threaded ____ Welded ____ Surface 12 in.
RMP ____ PVC X Weight 275 lbs./ft.
Dia. 5 in. to 50 ft. depth Wall Thickness: inches or
Dia. ____ in. to ____ ft. depth gage No. 250

5. Type and color of material	From	To
Clay yellow	0	23
Clay sandy	23	34
Clay sandy with white rock.	34	46
Sand (m.)	46	61
White Rock.	61	70

(Use a second sheet if needed)

10. Screen: Manufacturer's name Modean Pipes Inc.
Type PVC Dia. 5
Slot gauze .030 Length 20
Set between 50 ft. and 70 ft.
____ ft. and ____ ft.
Gravel pack? yes Size range of material 1/4-1/4

11. Static water level: mo./day/yr.
45 ft. below land surface Date 11-2-76

12. Pumping level below land surfaces:
____ ft. after ____ hrs. pumping ____ g.p.m.
____ ft. after ____ hrs. pumping ____ g.p.m.
Estimated maximum yield 20 g.p.m.

13. Water sample submitted: mo./day/yr.
__ Yes X No Date

14. Well head completion:
__ Pitless adapter 12 inches above grade

15. Well grouted? yes
With: __ Neat cement X Bentonite __ Concrete
Depth: From 0 ft. to 30 ft.

16. Nearest source of possible contamination:
ft. 30 Direction X Type corals
Well disinfected upon completion? X Yes __ No

17. Pump: __ Not installed
Manufacturer's name Monitor
Model number 142A HP 3/4 Volts 230
Length of drop pipe 54 ft. capacity 3 g.p.m.
Type:
__ Submersible __ Turbine
__ Jet X Reciprocating
__ Centrifugal __ Other Pump Jack.

18. Elevation:

Topography:
__ Hill
X Slope
__ Upland
__ Valley

19. Remarks: 2409 (HCPD)

20. Water well contractor's certification:
This well was drilled under my jurisdiction and this report is true to the best of my knowledge and belief.
Fawcett & Son Drilling 167
Business name License No.
Address Box 149 Norton Ks
Signed [signature] Date 3-11-77
Authorized representative

T 3 R 24 E/W Sec 30 1/4 NW 1/4 SW 1/4 NE

Forward the white, blue and pink copies to the Department of Health and Environment

Form WWC-5