


1 LOCATION OF WATER WELL: County: Norton Fraction: NE 1/4 SE 1/4 SW 1/4 Section Number: 31 Township Number: T 3 S Range Number: R 24 E

Distance and direction from nearest town or city street address of well if located within city?
10 Mile west 6 Mile South of Norton Kansas

2 WATER WELL OWNER: Janice Clark Board of Agriculture, Division of Water Resources
 RR#, St. Address, Box #: Rt 3 Norton Kansas 67154 Application Number:
 City, State, ZIP Code

3 LOCATE WELL'S LOCATION WITH AN "X" IN SECTION BOX:

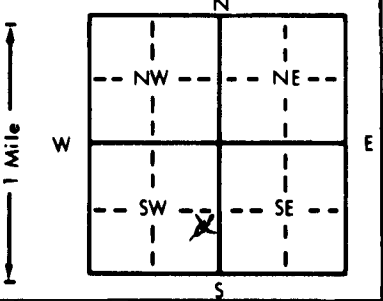

4 DEPTH OF COMPLETED WELL: 160 ft. ELEVATION: upland
 Depth(s) Groundwater Encountered 1. 124 ft. 2. ft. 3. ft.
 WELL'S STATIC WATER LEVEL: 124 ft. below land surface measured on mo/day/yr 6/10/81
 Pump test data: Well water was ft. after hours pumping gpm
 Est. Yield 12 gpm: Well water was ft. after hours pumping gpm
 Bore Hole Diameter: 9 in. to 160 ft., and in. to ft.
 WELL WATER TO BE USED AS:
 Domestic 3 Feedlot 6 Oil field water supply 9 Dewatering 12 Other (Specify below) Grazing Pasture
 Irrigation 4 Industrial 7 Lawn and garden only 10 Observation well
 Was a chemical/bacteriological sample submitted to Department? Yes No ; If yes, mo/day/yr sample was submitted
 Water Well Disinfected? Yes No

5 TYPE OF BLANK CASING USED:
 1 Steel 3 RMP (SR) 5 Wrought iron 8 Concrete tile CASING JOINTS: Glued Clamped
 PVC 4 ABS 7 Fiberglass Welded
 Blank casing diameter 5 in. to 140 ft., Dia. in. to ft., Dia. in. to ft.
 Casing height above land surface 14 in., weight 236 lbs./ft. Wall thickness or gauge No. 214
 TYPE OF SCREEN OR PERFORATION MATERIAL: PVC 10 Asbestos-cement
 1 Steel 3 Stainless steel 5 Fiberglass 8 RMP (SR) 11 Other (specify)
 2 Brass 4 Galvanized steel 6 Concrete tile 9 ABS 12 None used (open hole)
 SCREEN OR PERFORATION OPENINGS ARE:
 1 Continuous slot 3 Mill slot 5 Gauzed wrapped Saw cut 11 None (open hole)
 2 Louvered shutter 4 Key punched 6 Wire wrapped 9 Drilled holes
 7 Torch cut 10 Other (specify)
 SCREEN-PERFORATED INTERVALS: From 140 ft. to 160 ft., From ft. to ft.
 From ft. to ft., From ft. to ft.
 GRAVEL PACK INTERVALS: From 30 ft. to 160 ft., From ft. to ft.
 From ft. to ft., From ft. to ft.

6 GROUT MATERIAL: 1 Neat cement 2 Cement grout Bentonite 4 Other
 Grout Intervals: From 0 ft. to 30 ft., From ft. to ft., From ft. to ft.
 What is the nearest source of possible contamination:
 1 Septic tank 4 Lateral lines 7 Pit privy 10 Livestock pens 14 Abandoned water well
 2 Sewer lines 5 Cess pool 8 Sewage lagoon 11 Fuel storage 15 Oil well/Gas well
 3 Watertight sewer lines 6 Seepage pit 9 Feedyard 12 Fertilizer storage 16 Other (specify below) None
 13 Insecticide storage

Direction from well? How many feet?

FROM	TO	LITHOLOGIC LOG	FROM	TO	LITHOLOGIC LOG
0	27	Clay			
27	33	Sand			
33	35	White Rock			
35	48	White clay (soft)			
48	96	Sand stone			
96	119	Sand stone & Sand			
119	153	Fine Sand			
153	160	Clay			

7 CONTRACTOR'S OR LANDOWNER'S CERTIFICATION: This water well was constructed, reconstructed, or plugged under my jurisdiction and was completed on (mo/day/year) 8/12/81 and this record is true to the best of my knowledge and belief. Kansas Water Well Contractor's License No. 167 This Water Well Record was completed on (mo/day/yr) 8/28/81 under the business name of Fawcett Drilling by (signature) John R. Fawcett

INSTRUCTIONS: Use typewriter or ball point pen, PLEASE PRESS FIRMLY and PRINT clearly. Please fill in blanks, underline or circle the correct answers. Send top three copies to Kansas Department of Health and Environment, Division of Environment, Environmental Geology Section, Topeka, KS 66620. Send one to WATER WELL OWNER and retain one for your records.