

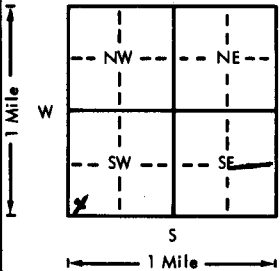
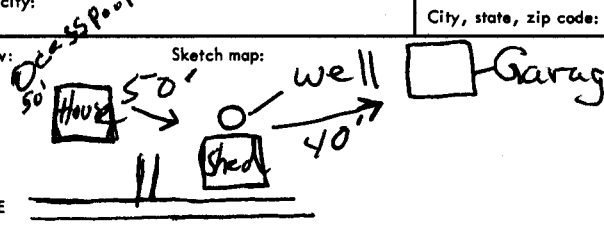
USE TYPEWRITER OR BALL POINT PEN-PRESS FIRMLY, PRINT CLEARLY.

*mountain*

WATER WELL RECORD  
KSA 82a-1201-1215

*CCC*

Kansas Department of Health and Environment-Division of Environment (Water well Contractors) Topeka, Kansas 66620

1. Location of well: County: <b>NORTON</b>		Fraction: <b>SW 1/4 SW 1/4 SW 1/4</b>		Section number: <b>8</b>		Township number: <b>T 3 S</b>		Range number: <b>R 25 E</b>	
2. Distance and direction from nearest town or city: <b>4 mi. N. of CLAYTON + 1/2 mi. E.</b>				3. Owner of well: <b>Faye Leichter</b> R.R. or street: <b>107 W. WAVERLY</b> City, state, zip code: <b>NORTON, KS. 67654</b>					
4. Locate with "X" in section below: 				Sketch map: 		6. Bore hole dia. <b>9</b> in. Completion date: <b>6/1/77</b> Well depth: <b>108</b> ft.			
				7. Cable tool <input checked="" type="checkbox"/> Rotary <input type="checkbox"/> Driven <input type="checkbox"/> Dug <input type="checkbox"/> Hollow rod <input type="checkbox"/> Jetted <input type="checkbox"/> Bored <input type="checkbox"/> Reverse rotary					
				8. Use: <input checked="" type="checkbox"/> Domestic <input type="checkbox"/> Public supply <input type="checkbox"/> Industry <input type="checkbox"/> Irrigation <input type="checkbox"/> Air conditioning <input type="checkbox"/> Stock <input type="checkbox"/> Lawn <input type="checkbox"/> Oil field water <input type="checkbox"/> Other					
				9. Casing: Material <b>PIST</b> Height: <b>(Above)</b> or below Threaded <input type="checkbox"/> Welded <b>91</b> Surface <b>24</b> in. RMP <input checked="" type="checkbox"/> PVC <input type="checkbox"/> Weight <input type="checkbox"/> lbs./ft. Dia. <b>5</b> in. to <b>90</b> ft. depth Wall Thickness: inches or Dia. <input type="checkbox"/> in. to <input type="checkbox"/> ft. depth Gauge No. <b>250</b>					
5. Type and color of material				From		To			
<b>CLAY + Rock ledges</b>				<b>0</b>		<b>96</b>		10. Screen: Manufacturer's name: <b>Jess &amp; Lowell</b>	
<b>SAND</b>				<b>96</b>		<b>104</b>		Type <b>plastic</b> Dia. <b>5 1/2</b>	
<b>SANDY CLAY</b>				<b>104</b>		<b>130</b>		Slot/gauze <b>1/16</b> Length <b>90'</b> <input checked="" type="checkbox"/> between <b>90</b> ft. and <b>100</b> ft. ft. and <input type="checkbox"/> ft.	
<b>BROCK ?</b>								Gravel pack? <input checked="" type="checkbox"/> <b>YES</b> Size range of material <b>1/4 - 5/8</b>	
								11. Static water level: <b>90'</b> mo./day/yr. <b>6-1-77</b>	
								12. Pumping level below land surfaces: <b>NOT PUMP</b>	
								____ ft. after ____ hrs. pumping ____ g.p.m.	
								____ ft. after ____ hrs. pumping ____ g.p.m.	
								Estimated maximum yield ____ g.p.m.	
								13. Water sample submitted: ____ mo./day/yr.	
								Yes <input checked="" type="checkbox"/> No <input type="checkbox"/> Date ____	
								14. Well head completion: <b>NOT DONE</b>	
								____ Pitless adapter ____ inches above grade	
								15. Well grouted? <b>yes</b>	
								With: <input checked="" type="checkbox"/> Neat cement <input type="checkbox"/> Bentonite <input type="checkbox"/> Concrete	
								Depth: From <b>5</b> ft. to <b>20</b> ft.	
								16. Nearest source of possible contamination: <b>Cess</b>	
								ft. <b>100</b> Direction <b>West</b> Type <b>Pool</b>	
								Well disinfected upon completion? <input checked="" type="checkbox"/> Yes <input type="checkbox"/> No	
								17. Pump: <input checked="" type="checkbox"/> Not installed	
								Manufacturer's name ____	
								Model number ____ HP ____ Volts ____	
								Length of drop pipe ____ ft. capacity ____ g.p.m.	
								Type:	
								<input type="checkbox"/> Submersible <input type="checkbox"/> Turbine	
								<input type="checkbox"/> Jet <input type="checkbox"/> Reciprocating	
								<input type="checkbox"/> Centrifugal <input type="checkbox"/> Other	
18. Elevation: <b>LEVEL</b>									
Topography: <input type="checkbox"/> Hill									
<input type="checkbox"/> Slope									
<input type="checkbox"/> Upland									
<input type="checkbox"/> Valley									
19. Remarks: <b>CONCRETE SLAB TO BE INSTALLED BY CUSTOMER AT GROUND SURFACE.</b>									
								20. Water well contractor's certification:	
								This well was drilled under my jurisdiction and this report is true to the best of my knowledge and belief.	
								<b>D&amp;L DRILLING 303</b>	
								Business name <b>D&amp;L DRILLING</b> License No. <b>303</b>	
								Address <b>Bx 368 Hill City, KS 67640</b>	
								Signed <b>Allyson</b> Date <b>10-10-77</b>	
								Authorized representative	

13  
 R  
 250  
 8  
 SWSWSW  
 1/4  
 1/4  
 1/4