


1 LOCATION OF WATER WELL: Fraction NE 1/4 NE 1/4 NE 1/4 Section Number 8 Township Number T 3 S Range Number R 25 EW
 County: Norton

Distance and direction from nearest town or city street address of well if located within city?
1 1/2 E., 1 S. of Norcater

2 WATER WELL OWNER: Wayne Leichliter Big Springs Drilling
 RR#, St. Address, Box #: Clayton, Kansas P. O. Box 694
 City, State, ZIP Code: Clayton, Kansas Great Bend, Ks 67530 Board of Agriculture, Division of Water Resources
 Application Number: T85-20

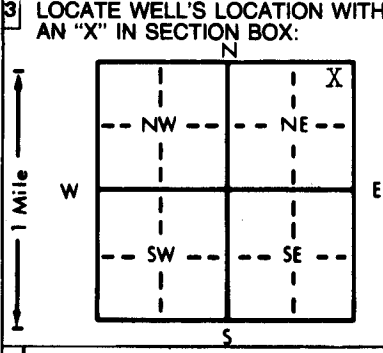

4 DEPTH OF COMPLETED WELL: 107. ft. ELEVATION:
 Depth(s) Groundwater Encountered 1. ft. 2. ft. 3. ft.
 WELL'S STATIC WATER LEVEL 52. ft. below land surface measured on mo/day/yr 12-23-84
 Pump test data: Well water was ft. after hours pumping gpm
 Est. Yield gpm: Well water was ft. after hours pumping gpm
 Bore Hole Diameter: 9. in. to 107. ft., and in. to ft.
 WELL WATER TO BE USED AS: 5 Public water supply 8 Air conditioning 11 Injection well
 1 Domestic 3 Feedlot 6 Oil field water supply 9 Dewatering 12 Other (Specify below)
 2 Irrigation 4 Industrial 7 Lawn and garden only 10 Observation well
 Was a chemical/bacteriological sample submitted to Department? Yes.....No.. X.....; If yes, mo/day/yr sample was submitted
 Water Well Disinfected? Yes No X

5 TYPE OF BLANK CASING USED: 5 Wrought iron 8 Concrete tile CASING JOINTS: Glued Clamped
 1 Steel 3 RMP (SR) 6 Asbestos-Cement 9 Other (specify below) Welded
 2 PVC 4 ABS 7 Fiberglass Threaded
 Blank casing diameter 5. in. to 87. ft., Dia in. to ft., Dia in. to ft.
 Casing height above land surface 12. in., weight 2.81 lbs./ft. Wall thickness or gauge No. 265
 TYPE OF SCREEN OR PERFORATION MATERIAL: 7 PVC 10 Asbestos-cement
 1 Steel 3 Stainless steel 5 Fiberglass 8 RMP (SR) 11 Other (specify)
 2 Brass 4 Galvanized steel 6 Concrete tile 9 ABS 12 None used (open hole)
 SCREEN OR PERFORATION OPENINGS ARE: 5 Gauzed wrapped 8 Saw cut 11 None (open hole)
 1 Continuous slot 3 Mill slot 6 Wire wrapped 9 Drilled holes
 2 Louvered shutter 4 Key punched 7 Torch cut 10 Other (specify)
 SCREEN-PERFORATED INTERVALS: From 87. ft. to 107. ft., From ft. to ft.
 From ft. to ft., From ft. to ft.
 GRAVEL PACK INTERVALS: From 10. ft. to 107. ft., From ft. to ft.
 From ft. to ft., From ft. to ft.

6 GROUT MATERIAL: 1 Neat cement 2 Cement grout 3 Bentonite 4 Other
 Grout Intervals: From 0. ft. to 10. ft., From ft. to ft., From ft. to ft.
 What is the nearest source of possible contamination:
 1 Septic tank 4 Lateral lines 7 Pit privy 10 Livestock pens 14 Abandoned water well
 2 Sewer lines 5 Cess pool 8 Sewage lagoon 11 Fuel storage 15 Oil well/Gas well
 3 Watertight sewer lines 6 Seepage pit 9 Feedyard 12 Fertilizer storage 16 Other (specify below)
 13 Insecticide storage
 Direction from well? South How many feet? 250'

FROM	TO	LITHOLOGIC LOG	FROM	TO	LITHOLOGIC LOG
0	3	0/ Clay	125	150	0/ Clay
3	14	03/ Caliche	150	28	28 Rock
14	23	08 Med Sand			
23	46	23 Caliche & Sandstone			
46	61	08 Med Sand			
61	67	0/ Clay			
67	70	08 Med Sand			
70	73	0/ Clay			
73	80	07 Fine Sand			
80	82	3/ Caliche			
82	84	07 Fine Sand			
84	91	23 Sandstone			
91	100	0/ Clay			
100	120	Caliche & Clay			
120	125	3/ Caliche			

7 CONTRACTOR'S OR LANDOWNER'S CERTIFICATION: This water well was (1) constructed, (2) reconstructed, or (3) plugged under my jurisdiction and was completed on (mo/day/year) 12-23-84 and this record is true to the best of my knowledge and belief. Kansas Water Well Contractor's License No. 394 This Water Well Record was completed on (mo/day/yr) 1-9-85 under the business name of Woofter Pump & Well by (signature) Walter Woofter

INSTRUCTIONS: Use typewriter or ball point pen, PLEASE PRESS FIRMLY and PRINT clearly. Please fill in blanks, underline or circle the correct answers. Send top three copies to Kansas Department of Health and Environment, Division of Environment, Environmental Geology Section, Topeka, KS 66620. Send one to WATER WELL OWNER and retain one for your records.