

WATER WELL PLUGGING RECORD

FORM WWC-5P


KSA 82a-1212

LOCATION OF WATER WELL:	Fraction	Section Number	Township Number	Range Number
County: <b>Norton</b>	<b>SE 1/4 SW 1/4 SW 1/4</b>	<b>2</b>	<b>3</b>	<b>25 W</b>

Distance and direction from nearest town or city street address of well if located within city?  
**West of Clayton to Rd W 13, N 4 miles to Rd N, E 1 1/4 North on north side**

WATER WELL OWNER: **Matthew Stevenson**  
 St. Address, Box # **4177 Rd N**  
 State, ZIP Code : **Norton, KS 67654**  
 Board of Agriculture, Division of Water Resources  
 Application Number:

MARK WELL'S LOCATON WITH AN "X" IN SECTION BOX:

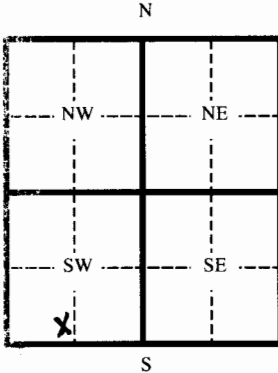

4 DEPTH OF WELL **100** ft.  
 WELL'S STATIC WATER LEVEL **85** ft.

WELL WAS USED AS:

- |  |                              |                    |
|--|------------------------------|--------------------|
| <input checked="" type="checkbox"/> 1 Domestic | 5 Public Water Supply        | 9 Dewatering       |
| 2 Irrigation                                   | 6 Oil Field Water Supply     | 10 Monitoring Well |
| 3 Feedlot                                      | 7 Lawn and Garden (domestic) | 11 Injection Well  |
| 4 Industrial                                   | 8                            | 12 Other           |

Was a chemical/bacteriological sample submitted to Department? Yes \_\_\_ No   
 If yes, mo/day/yr sample was submitted \_\_\_\_\_  
 Water Well Disinfected: Yes  No \_\_\_

TYPE OF BLANK CASING USED:  
 1 Steel      3 RMP (SR)      5 Wrought      7 Fiberglass      9 Other (specify below)  
 2 PVC      4 ABC      6 Asbestos-Cement      8 Concrete Tile  
 Blank casing diameter **4.5** in. Was casing pulled? Yes \_\_\_ No  If yes, how much \_\_\_\_\_

Casing height above or below land surface **-36** in.

GROUT PLUG MATERIAL: 1 Neat cement    2 Cement grout    3 Bentonite    4 Other \_\_\_\_\_  
 Grout Plug Intervals From **3** ft. to **6** ft. From **82** ft. to **85** ft. From \_\_\_\_\_ ft. to \_\_\_\_\_ ft.

What is the nearest source of possible contamination:  
 1 Septic tank      6 Seepage pit      11 Fuel storage      16 Other (specify below)  
 2 Sewer lines      7 Pit privy      12 Fertilizer storage  
 3 Watertight sewer lines      8 Sewage lagoon      13 Insecticide storage  
 4 Lateral lines      9 Feedyard      14 Abandoned water well  
 5 Cess Pool      10 Livestock pens      15 Oil well/ Gas well  
 Direction from well? \_\_\_\_\_ How many feet? \_\_\_\_\_

FROM	TO	CODE	PLUGGING MATERIALS
0	3		Clay
3	6		Bentonite
6	82		Clay
82	85		Bentonite
85	100		Chlorinated Sand

CONTRACTOR'S OR LANDOWNER'S CERTIFICATION: This water well was plugged under my jurisdiction and was completed on (mo/day/yr) **8/17/10** and this record is true to the best of my knowledge and belief. Kansas  
 Water Well Contractor's License No. **554/783** This Water Well Record was completed on (mo/day/yr) **9/13/10**  
 by (signature) \_\_\_\_\_ under the business name of **Woofert Pump & Well Inc.**

INSTRUCTIONS: Please fill in blanks and circle the correct answers. Send three copies to Kansas Department of Health and Environment, Bureau of Water, Topeka, Kansas 66620-0001. Telephone: 785-296-3565. Send one to Water Well Owner and retain one for your records.