WATER WELL RECORD Form WWC-5 KSA 82a-1212

1 LOCATION OF WATER WELL:	Fraction	Section Number	Township Number	Range Number
County: DECATUR	¼ SE ¼ SW ¼	6	T 3 S	R 28 E/W

Distance and direction from nearest town or city street address of well if located within city?
NA- LOCATION CONFIRMED BY GMD #4

2 WATER WELL OWNER: LAUREL L. HAYWARD
RR#, St. Address, Box # : 702 E. ADAMS
City, State, ZIP Code : OBERLIN, KANSAS 67749
Board of Agriculture, Division of Water Resourc
Application Number:

3 LOCATE WELL'S LOCATION WITH AN "X" IN SECTION BOX:

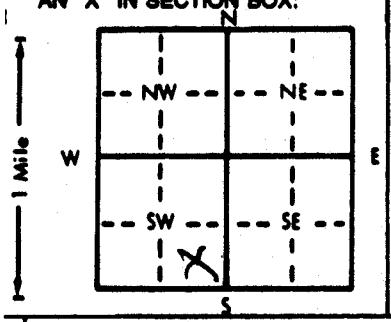

4 DEPTH OF COMPLETED WELL 45 ft. ELEVATION:
Depth(s) Groundwater Encountered 1. ft. 2. ft. 3. ft.
WELL'S STATIC WATER LEVEL 30 ft. below land surface measured on mo/day/yr May 13 1990
Pump test data: Well water was ft. after hours pumping gpr
Est. Yield gpm: Well water was ft. after hours pumping gpr
Bore Hole Diameter in. to ft., and in. to f
WELL WATER TO BE USED AS: 5 Public water supply 8 Air conditioning 11 Injection well
1 Domestic 3 Feedlot 6 Oil field water supply 9 Dewatering 12 Other (Specify below)
(2) Irrigation 4 Industrial 7 Lawn and garden only 10 Monitoring well
Was a chemical/bacteriological sample submitted to Department? Yes No; If yes, mo/day/yr sample was su
mitted Water Well Disinfected? Yes No

5 TYPE OF BLANK CASING USED: 5 Wrought iron 8 Concrete tile CASING JOINTS: Glued Clamped
(1) Steel 3 RMP (SR) 6 Asbestos-Cement 9 Other (specify below) Welded
2 PVC 4 ABS 7 Fiberglass Threaded
Blank casing diameter 36 in. to ft., Dia in. to ft., Dia in. to f
Casing height above land surface in., weight lbs./ft. Wall thickness or gauge No.

TYPE OF SCREEN OR PERFORATION MATERIAL: 7 PVC 10 Asbestos-cement
1 Steel 3 Stainless steel 5 Fiberglass 8 RMP (SR) 11 Other (specify)
2 Brass 4 Galvanized steel 6 Concrete tile 9 ABS 12 None used (open hole)

SCREEN OR PERFORATION OPENINGS ARE: 5 Gauzed wrapped 8 Saw cut 11 None (open hole)
1 Continuous slot 3 Mill slot 6 Wire wrapped 9 Drilled holes
2 Louvered shutter 4 Key punched 7 Torch cut 10 Other (specify)

SCREEN-PERFORATED INTERVALS: From ft. to ft., From ft. to f
From ft. to ft., From ft. to f
GRAVEL PACK INTERVALS: From ft. to ft., From ft. to f
From ft. to ft., From ft. to f

6 GROUT MATERIAL: 1 Neat cement 2 Cement grout (3) Bentonite 4 Other
Grout Intervals: From ft. to ft., From ft. to ft., From ft. to ft
What is the nearest source of possible contamination: 10 Livestock pens 14 Abandoned water well
1 Septic tank 4 Lateral lines 7 Pit privy 11 Fuel storage 15 Oil well/Gas well
2 Sewer lines 5 Cess pool 8 Sewage lagoon 12 Fertilizer storage 16 Other (specify below)
3 Watertight sewer lines 6 Seepage pit 9 Feedyard 13 Insecticide storage Well was located in a field-normal run-off
Direction from well? How many feet?

FROM	TO	LITHOLOGIC LOG	FROM	TO	PLUGGING INTERVALS
					Removed upper 3 ft. of casing
			45	28	Washed Gravel
			28	6	Clay
			6	3	Bentonite
			3	0	Clay and Black dirt
					Irrigation pump and pipe removed by well contractor
					3 gal. Clorox put in well to disinfect

RECEIVED
MAY 24 1990
DIVISION OF ENVIRONMENT

7 CONTRACTOR'S OR LANDOWNER'S CERTIFICATION: This water well was (1) constructed, (2) reconstructed, or (3) plugged under my jurisdiction and wa
completed on (mo/day/year) May 17, 1990 and this record is true to the best of my knowledge and belief. Kansa
Water Well Contractor's License No. This Water Well Record was completed on (mo/day/yr) May 20, 1990
under the business name of by (signature) Laurel L Hayward