


1 LOCATION OF WATER WELL: Fraction NW 1/4 SW 1/4 NW 1/4 Section Number 12 Township Number T 3 S Range Number R 28E/W
 County: Decatur
 Distance and direction from nearest town or city street address of well if located within city?

5 east 1 1/4 south of Oberlin

2 WATER WELL OWNER: Mrs Frank Spiers
 RR#, St. Address, Box # : Rt 1 Box 132
 City, State, ZIP Code : Oberlin, Ks 67749
 Board of Agriculture, Division of Water Resources
 Application Number:

3 LOCATE WELL'S LOCATION WITH AN "X" IN SECTION BOX:

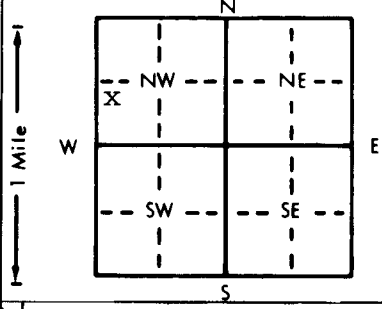

4 DEPTH OF COMPLETED WELL... 155 ft. ELEVATION:
 Depth(s) Groundwater Encountered 1. ft. 2. ft. 3. ft.
 WELL'S STATIC WATER LEVEL... 85 ft. below land surface measured on mo/day/yr 10-31-89
 Pump test data: Well water was not tested after hours pumping gpm
 Est. Yield gpm: Well water was not tested after hours pumping gpm
 Bore Hole Diameter... 8 in. to 155 ft., and in. to ft.
 WELL WATER TO BE USED AS:
 1 Domestic 3 Feedlot 6 Oil field water supply 9 Dewatering 12 Other (Specify below)
 2 Irrigation 4 Industrial 7 Lawn and garden only 10 Monitoring well
 Was a chemical/bacteriological sample submitted to Department? Yes... No... X...; If yes, mo/day/yr sample was submitted
 Water Well Disinfected? Yes X No

5 TYPE OF BLANK CASING USED:
 1 Steel 3 RMP (SR) 5 Wrought iron 8 Concrete tile CASING JOINTS: Glued X Clamped
 2 PVC 4 ABS 6 Asbestos-Cement 9 Other (specify below) Welded
 7 Fiberglass Threaded

Blank casing diameter 5 in. to 1.35 ft., Dia in. to ft., Dia in. to ft.
 Casing height above land surface 1.8 in., weight 1.8/10 lbs./ft. Wall thickness or gauge No. 1/4"

TYPE OF SCREEN OR PERFORATION MATERIAL:
 1 Steel 3 Stainless steel 5 Fiberglass 8 RMP (SR) 10 Asbestos-cement 11 Other (specify)
 2 Brass 4 Galvanized steel 6 Concrete tile 9 ABS 12 None used (open hole)

SCREEN OR PERFORATION OPENINGS ARE:
 1 Continuous slot 3 Mill slot 5 Gauzed wrapped 8 Saw cut 11 None (open hole)
 2 Louvered shutter 4 Key punched 6 Wire wrapped 9 Drilled holes
 7 Torch cut 10 Other (specify)

SCREEN-PERFORATED INTERVALS: From 1.35 ft. to 1.55 ft., From ft. to ft.
 GRAVEL PACK INTERVALS: From 1.8 ft. to 1.55 ft., From ft. to ft.

6 GROUT MATERIAL: 1 Neat cement 2 Cement grout 3 Bentonite 4 Other
 Grout Intervals: From 4 ft. to 1.8 ft., From ft. to ft., From ft. to ft.

What is the nearest source of possible contamination:
 1 Septic tank 4 Lateral lines 7 Pit privy 10 Livestock pens 14 Abandoned water well
 2 Sewer lines 5 Cess pool 8 Sewage lagoon 11 Fuel storage 15 Oil well/Gas well
 3 Watertight sewer lines 6 Seepage pit 9 Feedyard 12 Fertilizer storage 16 Other (specify below)
 13 Insecticide storage

Direction from well? north How many feet? 300

FROM	TO	LITHOLOGIC LOG	FROM	TO	PLUGGING INTERVALS
0	42	top soil			
42	66	sand and clay strips			
66	90	sand rock and sand strips			
90	96	sand rock hard			
96	132	sand and sand rock strips			
132	153	sand good			
153	155	oker			

7 CONTRACTOR'S OR LANDOWNER'S CERTIFICATION: This water well was (1) constructed, (2) reconstructed, or (3) plugged under my jurisdiction and was completed on (mo/day/year) 10-31-89 and this record is true to the best of my knowledge and belief. Kansas Water Well Contractor's License No. 139 This Water Well Record was completed on (mo/day/yr) 11-1-89 under the business name of Bartell Drilling by (signature) James Bartell