


1 LOCATION OF WATER WELL: County: Decatur Fraction: NE 1/4 NE 1/4 NE 1/4 Section Number: 35 Township Number: T 3 S Range Number: R 28 E/W

Distance and direction from nearest town or city street address of well if located within city? From Jennings, KS  
5 mi North 7 mi West West side of the 8 mi road.

2 WATER WELL OWNER: Larry Lively  
 RR#, St. Address, Box #: RT. 1 Board of Agriculture, Division of Water Resources  
 City, State, ZIP Code: Jennings, Kansas 67643 Application Number:

3 LOCATE WELL'S LOCATION WITH AN "X" IN SECTION BOX:

4 DEPTH OF COMPLETED WELL: 150 ft. ELEVATION:

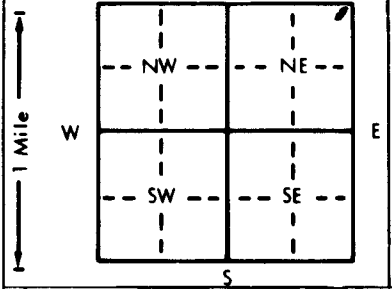

Depth(s) Groundwater Encountered 1. . . . . ft. 2. . . . . ft. 3. . . . . ft.  
 WELL'S STATIC WATER LEVEL 120 ft. below land surface measured on mo/day/yr  
 Pump test data: Well water was . . . . . ft. after . . . . . hours pumping . . . . . gpm  
 Est. Yield . . . . . gpm: Well water was . . . . . ft. after . . . . . hours pumping . . . . . gpm  
 Bore Hole Diameter: 9 in. to 20 ft., and 8 in. to 150 ft.  
 WELL WATER TO BE USED AS: 5 Public water supply 8 Air conditioning 11 Injection well  
1 Domestic 3 Feedlot 6 Oil field water supply 9 Dewatering 12 Other (Specify below)  
2 Irrigation 4 Industrial 7 Lawn and garden only 10 Monitoring well  
 Was a chemical/bacteriological sample submitted to Department? Yes. . . . . No.  If yes, mo/day/yr sample was submitted  
 Water Well Disinfected? Yes  No

5 TYPE OF BLANK CASING USED: 5 Wrought iron 8 Concrete tile CASING JOINTS: Glued  Clamped . . . . .  
 1 Steel 3 RMP (SR) 6 Asbestos-Cement 9 Other (specify below) Welded . . . . .  
2 PVC 4 ABS 7 Fiberglass Threaded . . . . .

Blank casing diameter: 5 in. to 120 ft., Dia. . . . . in. to . . . . . ft., Dia. . . . . in. to . . . . . ft.  
 Casing height above land surface: 12 in., weight . . . . . lbs./ft. Wall thickness or gauge No. 5 DR 21

TYPE OF SCREEN OR PERFORATION MATERIAL: 7 PVC 10 Asbestos-cement  
 1 Steel 3 Stainless steel 5 Fiberglass 8 RMP (SR) 11 Other (specify) . . . . .  
 2 Brass 4 Galvanized steel 6 Concrete tile 9 ABS 12 None used (open hole)

SCREEN OR PERFORATION OPENINGS ARE: 5 Gauzed wrapped 8 Saw cut 11 None (open hole)  
 1 Continuous slot 3 Mill slot 6 Wire wrapped 9 Drilled holes  
 2 Louvered shutter 4 Key punched 7 Torch cut 10 Other (specify) . . . . .

SCREEN-PERFORATED INTERVALS: From 120 ft. to 150 ft., From . . . . . ft. to . . . . . ft.  
 From . . . . . ft. to . . . . . ft., From . . . . . ft. to . . . . . ft.

GRAVEL PACK INTERVALS: From 25 ft. to 150 ft., From . . . . . ft. to . . . . . ft.  
 From . . . . . ft. to . . . . . ft., From . . . . . ft. to . . . . . ft.

6 GROUT MATERIAL: 1 Neat cement 2 Cement grout 3 Bentonite 4 Other . . . . .  
 Grout Intervals: From 5 ft. to 25 ft., From . . . . . ft. to . . . . . ft., From . . . . . ft. to . . . . . ft.

What is the nearest source of possible contamination:  
 1 Septic tank 4 Lateral lines 7 Pit privy 10 Livestock pens 14 Abandoned water well  
 2 Sewer lines 5 Cess pool 8 Sewage lagoon 11 Fuel storage 15 Oil well/Gas well  
 3 Watertight sewer lines 6 Seepage pit 9 Feedyard 12 Fertilizer storage 16 Other (specify below)  
10th. n. 9

Direction from well? How many feet?

FROM	TO	LITHOLOGIC LOG	FROM	TO	PLUGGING INTERVALS
0	32	Top Soil & Clay			
32	55	Sandstone, fine sand clay			
55	145	Fine sand Sandstone			
145	152	Sandstone, clay & chert			


7 CONTRACTOR'S OR LANDOWNER'S CERTIFICATION: This water well was (1) constructed, (2) reconstructed, or (3) plugged under my jurisdiction and was completed on (mo/day/year) 2-19-91 and this record is true to the best of my knowledge and belief. Kansas Water Well Contractor's License No. 428 This Water Well Record was completed on (mo/day/yr) 6-29-91 under the business name of STALDER DRILLING by (signature) Jerry L. Stalder