


1 LOCATION OF WATER WELL: County: Decatur	Fraction NE 1/4 NW 1/4 SW 1/4	Section Number 1	Township Number T 3 S	Range Number R 29 EW
--	----------------------------------	---------------------	--------------------------	-------------------------

Distance and direction from nearest town or city street address of well if located within city?
 120 W Commercial Oberlin

2 WATER WELL OWNER: D. J. Fredrickson
 RR#, St. Address, Box #: 510 E Oak Board of Agriculture, Division of Water Resources
 City, State, ZIP Code: Oberlin KS 67749 Application Number:

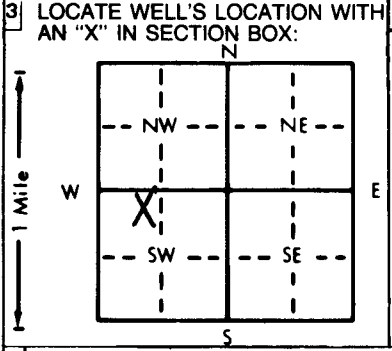

4 DEPTH OF COMPLETED WELL: 43.0' ft. ELEVATION: 2560.51
 Depth(s) Groundwater Encountered 1. 31.5' ft. 2. ft. 3. ft.
 WELL'S STATIC WATER LEVEL: 29.49' ft. below land surface measured on mo/day/yr
 Pump test data: Well water was ft. after hours pumping gpm
 Est. Yield gpm: Well water was ft. after hours pumping gpm
 Bore Hole Diameter: 8" in. to ft., and in. to ft.
 WELL WATER TO BE USED AS:
 5 Public water supply 8 Air conditioning 11 Injection well
 1 Domestic 3 Feedlot 6 Oil field water supply 9 Dewatering 12 Other (Specify below)
 2 Irrigation 4 Industrial 7 Lawn and garden only 10 Monitoring well
 Was a chemical/bacteriological sample submitted to Department? Yes No X; If yes, mo/day/yr sample was submitted
 Water Well Disinfected? Yes No X

5 TYPE OF BLANK CASING USED:
 1 Steel 3 RMP (SR) 5 Wrought iron 8 Concrete tile CASING JOINTS: Glued Clamped
 2 PVC 4 ABS 6 Asbestos-Cement 9 Other (specify below) Welded
 7 Fiberglass Threaded Flush
 Blank casing diameter: 2" in. to ft., Dia. in. to ft., Dia. in. to ft.
 Casing height above land surface: Flush in., weight: .703 lbs./ft. Wall thickness or gauge No.: .154
 TYPE OF SCREEN OR PERFORATION MATERIAL:
 1 Steel 3 Stainless steel 5 Fiberglass 7 PVC 10 Asbestos-cement
 2 Brass 4 Galvanized steel 6 Concrete tile 8 RMP (SR) 11 Other (specify)
 12 None used (open hole)
 SCREEN OR PERFORATION OPENINGS ARE:
 1 Continuous slot 3 Mill slot 5 Gauzed wrapped 8 Saw cut 11 None (open hole)
 2 Louvered shutter 4 Key punched 6 Wire wrapped 9 Drilled holes
 7 Torch cut 10 Other (specify)
 SCREEN-PERFORATED INTERVALS: From 22.75' ft. to 42.75' ft., From ft. to ft.
 GRAVEL PACK INTERVALS: From 20.75' ft. to 42.75' ft., From ft. to ft.

6 GROUT MATERIAL: 1 Neat cement 2 Cement grout 3 Bentonite 4 Other
 Grout Intervals: From 20.75' ft. to 1.0' ft., From ft. to ft., From ft. to ft.
 What is the nearest source of possible contamination:
 1 Septic tank 4 Lateral lines 7 Pit privy 10 Livestock pens 14 Abandoned water well
 2 Sewer lines 5 Cess pool 8 Sewage lagoon 11 Fuel storage 15 Oil well/Gas well
 3 Watertight sewer lines 6 Seepage pit 9 Feedyard 12 Fertilizer storage 16 Other (specify below)
 13 Insecticide storage
 Direction from well? How many feet?

FROM	TO	LITHOLOGIC LOG	FROM	TO	PLUGGING INTERVALS
0.0'	0.5'	Concrete.			
0.5'	6.0'	Clay, silty.			
6.0'	30.0'	Clay.			
30.0'	31.5'	Clay, very silty.			
31.5'	43.0'	Sand.			
Waiver for Flushmounts for Kellings Fine Foods Dated 2-4-92 Signed by Don Taylor					

7 CONTRACTOR'S OR LANDOWNER'S CERTIFICATION: This water well was (1) constructed (2) reconstructed, or (3) plugged under my jurisdiction and was completed on (mo/day/year) 2-13-92 and this record is true to the best of my knowledge and belief. Kansas Water Well Contractor's License No. 531 This Water Well Record was completed on (mo/day/yr) 4-8-92 under the business name of Geotechnical Services, Inc. by (signature) Allison Irwin