


1 LOCATION OF WATER WELL: County: Decatur	Fraction NE 1/4 NW 1/4 SW 1/4	Section Number 1	Township Number T 3 S	Range Number R 29 (EW)
--	----------------------------------	---------------------	--------------------------	----------------------------------

Distance and direction from nearest town or city street address of well if located within city?
 120 W Commercial Oberlin

2 WATER WELL OWNER: D. J. Fredrickson
 RR#, St. Address, Box # : 510 E Oak Board of Agriculture, Division of Water Resources
 City, State, ZIP Code : Oberlin KS 67749 Application Number:

3 LOCATE WELL'S LOCATION WITH AN "X" IN SECTION BOX:

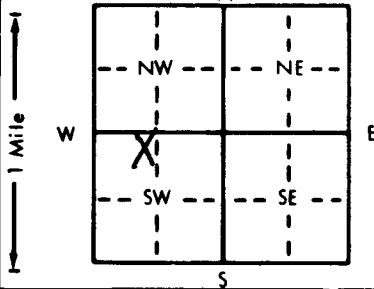

4 DEPTH OF COMPLETED WELL: 43.0' ft. ELEVATION: 2560.81
 Depth(s) Groundwater Encountered 1. N.A. ft. 2. ft. 3. ft.
 WELL'S STATIC WATER LEVEL 29.82 ft. below land surface measured on mo/day/yr
 Pump test data: Well water was ft. after hours pumping gpm
 Est. Yield gpm: Well water was ft. after hours pumping gpm
 Bore Hole Diameter: 8" in. to ft., and in. to ft.
 WELL WATER TO BE USED AS:
 5 Public water supply 8 Air conditioning 11 Injection well
 1 Domestic 3 Feedlot 6 Oil field water supply 9 Dewatering 12 Other (Specify below)
 2 Irrigation 4 Industrial 7 Lawn and garden only **10 Monitoring well**
 Was a chemical/bacteriological sample submitted to Department? Yes.....No.....**X**.....; If yes, mo/day/yr sample was submitted
 Water Well Disinfected? Yes No **X**

5 TYPE OF BLANK CASING USED:
 1 Steel 3 RMP (SR) 5 Wrought iron 8 Concrete tile CASING JOINTS: Glued.....Clamped.....
2 PVC 4 ABS 7 Fiberglass Welded.....
 Blank casing diameter 2" in. to ft., Dia in. to ft., Dia in. to ft.
 Casing height above land surface: Flush in., weight 703 lbs./ft. Wall thickness or gauge No. 154
 TYPE OF SCREEN OR PERFORATION MATERIAL:
 1 Steel 3 Stainless steel 5 Fiberglass **7 PVC** 10 Asbestos-cement
 2 Brass 4 Galvanized steel 6 Concrete tile 9 ABS 11 Other (specify).....
 12 None used (open hole)
 SCREEN OR PERFORATION OPENINGS ARE:
 1 Continuous slot 2 Mill slot 3 Mill slot 4 Key punched 5 Gauzed wrapped 8 Saw cut 11 None (open hole)
 2 Louvered shutter 4 Key punched 6 Wire wrapped 9 Drilled holes
 7 Torch cut 10 Other (specify).....
 SCREEN-PERFORATED INTERVALS: From 22.75' ft. to 42.75' ft., From ft. to ft.
 From ft. to ft., From ft. to ft.
 GRAVEL PACK INTERVALS: From 20.75' ft. to 42.75' ft., From ft. to ft.
 From ft. to ft., From ft. to ft.

6 GROUT MATERIAL: 1 Neat cement 2 Cement grout **3 Bentonite** 4 Other.....
 Grout Intervals: From 20.75' ft. to 1.0' ft., From ft. to ft., From ft. to ft.
 What is the nearest source of possible contamination:
 1 Septic tank 4 Lateral lines 7 Pit privy **11 Fuel storage** 14 Abandoned water well
 2 Sewer lines 5 Cess pool 8 Sewage lagoon 12 Fertilizer storage 15 Oil well/Gas well
 3 Watertight sewer lines 6 Seepage pit 9 Feedyard 13 Insecticide storage 16 Other (specify below)

Direction from well?		LITHOLOGIC LOG		PLUGGING INTERVALS	
FROM	TO	FROM	TO	FROM	TO
0.0'	2.0'				
2.0'	6.0'		Brick surface then rubble.		
6.0'	30.0'		Clay, silty.		
30.0'	33.0'		Clay.		
33.0'	43.0'		Clay, very silty.		
			Sand.		
Waiver for Flushmounts for Kelling Fine Foods Dated 2-4-92 Signed by Don Taylor					

7 CONTRACTOR'S OR LANDOWNER'S CERTIFICATION: This water well was **(1) constructed** (2) reconstructed, or (3) plugged under my jurisdiction and was completed on (mo/day/year) 2-12-92 and this record is true to the best of my knowledge and belief. Kansas Water Well Contractor's License No. 531 This Water Well Record was completed on (mo/day/yr) 4-8-92 under the business name of Geotechnical Services, Inc. by (signature) Allison Lawren