


1 LOCATION OF WATER WELL: County: **Decatur** Fraction: **NE 1/4 NW 1/4 SW 1/4** Section Number: **1** Township Number: **T 3 S** Range Number: **R 29 E** **(W)**

Distance and direction from nearest town or city street address of well if located within city?
202 W. Commercial, Oberlin, Ks.

2 WATER WELL OWNER: RR#, St. Address, Box #: **Decatur Co-op** Board of Agriculture, Division of Water Resources
 City, State, ZIP Code: **Oberlin, Ks. 67749** MW #6 Application Number:

3 LOCATE WELL'S LOCATION WITH AN "X" IN SECTION BOX:

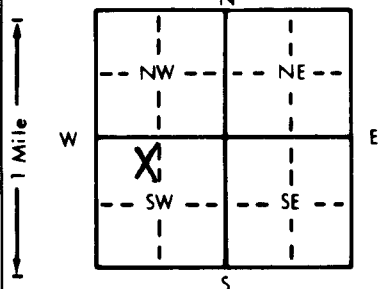

4 DEPTH OF COMPLETED WELL: **37** ft. ELEVATION:

Depth(s) Groundwater Encountered 1. ft. 2. ft. 3. ft.
 WELL'S STATIC WATER LEVEL . . . **29** . . . ft. below land surface measured on mo/day/yr
 Pump test data: Well water was ft. after hours pumping gpm
 Est. Yield gpm: Well water was ft. after hours pumping gpm
 Bore Hole Diameter . . . **7.5/8** in. to **42.5** ft., and in. to ft.
 WELL WATER TO BE USED AS: 5 Public water supply 8 Air conditioning 11 Injection well
 1 Domestic 3 Feedlot 6 Oil field water supply 9 Dewatering 12 Other (Specify below)
 2 Irrigation 4 Industrial 7 Lawn and garden only 10 Monitoring well
 Was a chemical/bacteriological sample submitted to Department? Yes No. **X**; If yes, mo/day/yr sample was submitted
 Water Well Disinfected? Yes No **X**

5 TYPE OF BLANK CASING USED: 5 Wrought iron 8 Concrete tile CASING JOINTS: Glued Clamped
 1 Steel 3 RMP (SR) 6 Asbestos-Cement 9 Other (specify below) Welded
 2 PVC 4 ABS 7 Fiberglass Threaded. **X**
 Blank casing diameter . . . **2** . . . in. to **22** . . . ft., Dia in. to ft., Dia in. to ft.
 Casing height above land surface **0** . . . in., weight . . . **.716** . . . lbs./ft. Wall thickness or gauge No. . . . **.154** . . .

TYPE OF SCREEN OR PERFORATION MATERIAL: 7 PVC 10 Asbestos-cement
 1 Steel 3 Stainless steel 5 Fiberglass 8 RMP (SR) 11 Other (specify)
 2 Brass 4 Galvanized steel 6 Concrete tile 9 ABS 12 None used (open hole)
 SCREEN OR PERFORATION OPENINGS ARE: 5 Gauzed wrapped 8 Saw cut 11 None (open hole)
 1 Continuous slot 3 Mill slot 6 Wire wrapped 9 Drilled holes
 2 Louvered shutter 4 Key punched 7 Torch cut 10 Other (specify)
 SCREEN-PERFORATED INTERVALS: From . . . **22** . . . ft. to **37** . . . ft., From ft. to ft.
 From ft. to ft., From ft. to ft.
 GRAVEL PACK INTERVALS: From . . . **20** . . . ft. to **42.5** . . . ft., From ft. to ft.
 From ft. to ft., From ft. to ft.

6 GROUT MATERIAL: 1 Neat cement 2 Cement grout 3 Bentonite 4 Other
 Grout Intervals: From . . . **0** . . . ft. to . . . **17** . . . ft., From . . . **17** . . . ft. to . . . **20** . . . ft., From ft. to ft.
 What is the nearest source of possible contamination:
 1 Septic tank 4 Lateral lines 7 Pit privy 10 Livestock pens 14 Abandoned water well
 2 Sewer lines 5 Cess pool 8 Sewage lagoon 11 Fuel storage 15 Oil well/Gas well
 3 Watertight sewer lines 6 Seepage pit 9 Feedyard 12 Fertilizer storage 16 Other (specify below)
 13 Insecticide storage **Removed Fuel Storage**

Direction from well? How many feet?

FROM	TO	LITHOLOGIC LOG	FROM	TO	PLUGGING INTERVALS
0	3	Surface			
3	8	Drk. Brwn Silty Clay to Clayey Silt/Trace Sand			
8	37	Olive Gray/Greenish Brown Silty Clay to Clayey Silt/Trace Sand			

7 CONTRACTOR'S OR LANDOWNER'S CERTIFICATION: This water well was (1) constructed, (2) reconstructed, or (3) plugged under my jurisdiction and was completed on (mo/day/year) . . . **7-21-93** and this record is true to the best of my knowledge and belief. Kansas Water Well Contractor's License No. **554** This Water Well Record was completed on (mo/day/yr) **7-29-93** under the business name of **Woofter Pump & Well, Inc.** by (signature) *Gay C. Woofter*