


1 LOCATION OF WATER WELL: Fraction Se 1/4 NW 1/4 SW 1/4 Section Number 1 Township Number T 3 S Range Number R 29 E/W
 County: Decatur

Distance and direction from nearest town or city street address of well if located within city?
Sotuh Rodehaven, Oberlin, Kansas

2 WATER WELL OWNER: City of Oberlin
 RR#, St. Address, Box # : 107 N. Commercial Board of Agriculture, Division of Water Resources
 City, State, ZIP Code : Oberlin, KS 67746 Application Number:

3 LOCATE WELL'S LOCATION WITH AN "X" IN SECTION BOX:

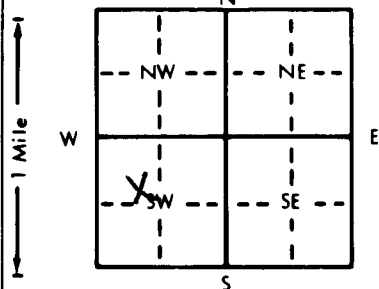

4 DEPTH OF COMPLETED WELL: 34.0 ft. ELEVATION:
 Depth(s) Groundwater Encountered 1. 23.0 ft. 2. ft. 3. ft.
 WELL'S STATIC WATER LEVEL ft. below land surface measured on mo/day/yr
 Pump test data: Well water was ft. after hours pumping gpm
 Est. Yield gpm: Well water was ft. after hours pumping gpm
 Bore Hole Diameter. . . 7.5 in. to 34.0 ft., and in. to ft.

WELL WATER TO BE USED AS: 5 Public water supply 8 Air conditioning 11 Injection well
 1 Domestic 3 Feedlot 6 Oil field water supply 9 Dewatering 12 Other (Specify below)
 2 Irrigation 4 Industrial 7 Lawn and garden only 10 Monitoring well OBW-2
 Was a chemical/bacteriological sample submitted to Department? Yes No X ; If yes, mo/day/yr sample was sub-
 mitted Water Well Disinfected? Yes No X

5 TYPE OF CASING USED: 5 Wrought iron 8 Concrete tile CASING JOINTS: Glued Clamped
 1 Steel 3 RMP (SR) 6 Asbestos-Cement 9 Other (specify below) Welded
2 PVC 4 ABS 7 Fiberglass Threaded
 Blank casing diameter . . . 2.0 in. to 19.0 ft., Dia in. to ft., Dia in. to ft.
 Casing height above land surface . . . 0.0 in., weight lbs./ft. Wall thickness or gauge No. Sc hd. 40

TYPE OF SCREEN OR PERFORATION MATERIAL: 7 PVC 10 Asbestos-cement
 1 Steel 3 Stainless steel 5 Fiberglass 8 RMP (SR) 11 Other (specify)
 2 Brass 4 Galvanized steel 6 Concrete tile 9 ABS 12 None used (open hole)

SCREEN OR PERFORATION OPENINGS ARE: 5 Gauzed wrapped 8 Saw cut 11 None (open hole)
 1 Continuous slot 3 Mill slot 6 Wire wrapped 9 Drilled holes
 2 Louvered shutter 4 Key punched 7 Torch cut 10 Other (specify)

SCREEN-PERFORATED INTERVALS: From 34.0 ft. to 19.0 ft., From ft. to ft.
 From ft. to ft., From ft. to ft.
 GRAVEL PACK INTERVALS: From 34.0 ft. to 16.0 ft., From ft. to ft.
 From ft. to ft., From ft. to ft.

6 GROUT MATERIAL: 1 Neat cement 2 Cement grout 3 Bentonite 4 Other
 Grout Intervals: From 16.0 ft. to 13.0 ft., From 13.0 ft. to 0.0 ft., From ft. to ft.

What is the nearest source of possible contamination:
 1 Septic tank 4 Lateral lines 7 Pit privy 10 Livestock pens 14 Abandoned water well
 2 Sewer lines 5 Cess pool 8 Sewage lagoon 11 Fuel storage 15 Oil well/Gas well
 3 Watertight sewer lines 6 Seepage pit 9 Feedyard 12 Fertilizer storage 16 Other (specify below)
 13 Insecticide storage

Direction from well? How many feet?

FROM	TO	LITHOLOGIC LOG	FROM	TO	PLUGGING INTERVALS
0	5	6" asphalt, silty clay, loam, dark brown, clay tan, lean, moist, no odor			
5	10	Clay, tan to medium brown, lean, moist, no odor			
10	15	Clay, medium brown, lean, moist, no odor			
15	20	Clay medium to dark brown, lean, moist, no odor			
20	25	Sandy clay, medium to dark brown, lean, saturated at 23', no odor			
25	30	Sandy clay, fine grain, lean, dark gray to black, saturated, no odor			
30	35	Sand, tan, fine grain, saturated, no odor			

7 CONTRACTOR'S OR LANDOWNER'S CERTIFICATION: This water well was (1) constructed, (2) reconstructed, or (3) plugged under my jurisdiction and was completed on (mo/day/year) 12-14-93 and this record is true to the best of my knowledge and belief. Kansas Water Well Contractor's License No. 540 This Water Well Record was completed on (mo/day/yr) 1-4-94 under the business name of Prairie Land Environmental Remediation, Inc. By (signature) [Signature]