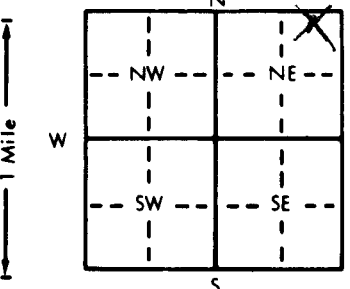


1 LOCATION OF WATER WELL:		Fraction	Section Number	Township Number	Range Number
County: Decatur		N 1/4 NE 1/4	5	T 3 S	R 29 E/W
Distance and direction from nearest town or city street address of well if located within city? 3 #miles west of Oberlin, Kansas					
2 WATER WELL OWNER:					
RR#, St. Address, Box # : Robert May			Board of Agriculture, Division of Water Resources		
City, State, ZIP Code : Oberlin, Kansas			Application Number:		
3 LOCATE WELL'S LOCATION WITH AN "X" IN SECTION BOX:		4 DEPTH OF COMPLETED WELL: 150 ft. ELEVATION:			
		Depth(s) Groundwater Encountered 1. 115 ft. 2. ft. 3. ft.			
		WELL'S STATIC WATER LEVEL 115 ft. below land surface measured on mo/day/yr			
		Pump test data: Well water was ft. after hours pumping gpm			
		Est. Yield 7 gpm: Well water was ft. after hours pumping gpm			
		Bore Hole Diameter 7" in. to ft., and in. to ft.			
WELL WATER TO BE USED AS:		5 Public water supply 8 Air conditioning 11 Injection well			
1 Domestic 3 Feedlot 6 Oil field water supply 9 Dewatering 12 Other (Specify below)					
2 Irrigation 4 Industrial 7 Lawn and garden only 10 Observation well					
Was a chemical/bacteriological sample submitted to Department? Yes.....No X; If yes, mo/day/yr sample was submitted					
Water Well Disinfected? Yes X No					
5 TYPE OF BLANK CASING USED:					
1 Steel 3 RMP (SR) 6 Asbestos-Cement 9 Other (specify below)		8 Concrete tile CASING JOINTS: Glued XXX Clamped			
2 PVC 4 ABS 7 Fiberglass		Welded			
		Threaded.			
Blank casing diameter 4" in. to 140 ft., Dia. in. to ft., Dia. in. to ft.					
Casing height above land surface 12" in., weight lbs./ft. Wall thickness or gauge No. .214+					
TYPE OF SCREEN OR PERFORATION MATERIAL:					
1 Steel 3 Stainless steel 5 Fiberglass 8 RMP (SR) 11 Other (specify)		7 PVC 10 Asbestos-cement			
2 Brass 4 Galvanized steel 6 Concrete tile 9 ABS 12 None used (open hole)					
SCREEN OR PERFORATION OPENINGS ARE:					
1 Continuous slot 3 Mill slot 5 Gauzed wrapped 8 <u>Saw cut</u> 11 None (open hole)					
2 Louvered shutter 4 Key punched 6 Wire wrapped 9 Drilled holes					
		7 Torch cut 10 Other (specify)			
SCREEN-PERFORATED INTERVALS: From 140 ft. to 150 ft., From ft. to ft.					
From ft. to ft., From ft. to ft.					
GRAVEL PACK INTERVALS: From 150 ft. to 15 ft., From ft. to ft.					
From ft. to ft., From ft. to ft.					
6 GROUT MATERIAL: 1 Neat cement 2 <u>Cement grout</u> 3 Bentonite 4 Other					
Grout Intervals: From 15 ft. to 5 ft., From ft. to ft., From ft. to ft.					
What is the nearest source of possible contamination:					
1 Septic tank 4 Lateral lines 7 Pit privy 10 <u>Livestock pens</u> 14 Abandoned water well					
2 Sewer lines 5 Cess pool 8 Sewage lagoon 11 <u>Fuel storage</u> 15 Oil well/Gas well					
3 Watertight sewer lines 6 Seepage pit 9 Feedyard 12 Fertilizer storage 16 Other (specify below)					
		13 Insecticide storage			
Direction from well? How many feet? 150" ft. west					
FROM	TO	LITHOLOGIC LOG	FROM	TO	LITHOLOGIC LOG
0	58	Top			
58	65	sandy clay			
65	70	lime stone			
70	90	sandy clay			
90	98	sand Drill slow tight			
98	100	clay			
100	117	sand			
117	140	sandy clay			
140	150	sand			
150		shale			
7 CONTRACTOR'S OR LANDOWNER'S CERTIFICATION: This water well was (1) constructed, (2) reconstructed, or (3) plugged under my jurisdiction and was completed on (mo/day/year) 9/17/1985 and this record is true to the best of my knowledge and belief. Kansas Water Well Contractor's License No. 398 This Water Well Record was completed on (mo/day/yr) 9/25/1985 under the business name of Kelley Drilling Co. by (signature) <i>Richard Kelley</i>					
INSTRUCTIONS: Use typewriter or ball point pen, PLEASE PRESS FIRMLY and PRINT clearly. Please fill in blanks, underline or circle the correct answers. Send top three copies to Kansas Department of Health and Environment, Division of Environment, Environmental Geology Section, Topeka, KS 66620. Send one to WATER WELL OWNER and retain one for your records.					