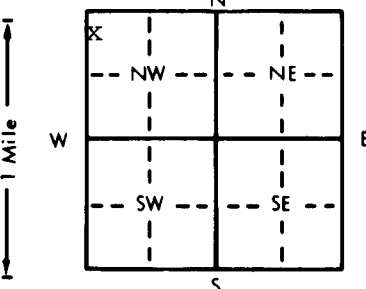


1 LOCATION OF WATER WELL:		Fraction	Section Number	Township Number	Range Number
County: <u>Decatur</u>		<u>NW 1/4</u> <u>NW 1/4</u> <u>NW 1/4</u>	<u>10</u>	<u>T</u> <u>3</u> <u>S</u>	<u>R</u> <u>29</u> <u>E/W</u>
Distance and direction from nearest town or city street address of well if located within city? <u>1 1/2 west of Oberlin</u>					
2 WATER WELL OWNER:		Pauline Zander			
RR#, St. Address, Box # :		Rt 2 Box 137		Board of Agriculture, Division of Water Resources	
City, State, ZIP Code :		Oberlin, Ks 67749		Application Number:	
3 LOCATE WELL'S LOCATION WITH AN "X" IN SECTION BOX:		4 DEPTH OF COMPLETED WELL: <u>108</u> ft. ELEVATION:			
		Depth(s) Groundwater Encountered 1. ft. 2. ft. 3. ft.			
		WELL'S STATIC WATER LEVEL <u>83</u> ft. below land surface measured on mo/day/yr <u>10-30-89</u>			
		Pump test data: Well water was ft. after hours pumping gpm			
		Est. Yield gpm: Well water was ft. after hours pumping gpm			
		Bore Hole Diameter <u>8</u> in. to <u>108</u> not tested in. to ft.			
WELL WATER TO BE USED AS:		5 Public water supply 8 Air conditioning 11 Injection well			
1 Domestic 3 Feedlot 6 Oil field water supply 9 Dewatering 12 Other (Specify below)					
2 Irrigation 4 Industrial 7 Lawn and garden only 10 Monitoring well					
Was a chemical/bacteriological sample submitted to Department? Yes.....No. <u>X</u>; If yes, mo/day/yr sample was submitted		Water Well Disinfected? Yes <u>X</u> No			
5 TYPE OF BLANK CASING USED:		5 Wrought iron 8 Concrete tile		CASING JOINTS: Glued <u>X</u> Clamped	
1 Steel 3 RMP (SR)		6 Asbestos-Cement 9 Other (specify below)		Welded	
2 PVC 4 ABS		7 Fiberglass		Threaded	
Blank casing diameter <u>5</u> in. to <u>88</u> ft., Dia. in. to ft., Dia. in. to ft.					
Casing height above land surface <u>1.8</u> in., weight <u>1.8/10</u> lbs./ft. Wall thickness or gauge No. <u>1/4</u> "					
TYPE OF SCREEN OR PERFORATION MATERIAL:		7 PVC 10 Asbestos-cement			
1 Steel 3 Stainless steel 5 Fiberglass 8 RMP (SR) 11 Other (specify)					
2 Brass 4 Galvanized steel 6 Concrete tile 9 ABS 12 None used (open hole)					
SCREEN OR PERFORATION OPENINGS ARE:		5 Gauzed wrapped 8 Saw cut 11 None (open hole)			
1 Continuous slot 3 Mill slot 6 Wire wrapped 9 Drilled holes					
2 Louvered shutter 4 Key punched 7 Torch cut 10 Other (specify)					
SCREEN-PERFORATED INTERVALS: From <u>88</u> ft. to <u>108</u> ft., From ft. to ft.					
GRAVEL PACK INTERVALS: From <u>1.8</u> ft. to <u>108</u> ft., From ft. to ft.					
6 GROUT MATERIAL: 1 Neat cement 2 Cement grout 3 Bentonite 4 Other					
Grout Intervals: From <u>4</u> ft. to <u>18</u> ft., From ft. to ft., From ft. to ft.					
What is the nearest source of possible contamination:		10 Livestock pens 14 Abandoned water well			
1 Septic tank 4 Lateral lines 7 Pit privy 11 Fuel storage 15 Oil well/Gas well					
2 Sewer lines 5 Cess pool 8 Sewage lagoon 12 Fertilizer storage 16 Other (specify below)					
3 Watertight sewer lines 6 Seepage pit 9 Feedyard 13 Insecticide storage					
Direction from well? <u>east</u>		How many feet? <u>110</u>			
FROM	TO	LITHOLOGIC LOG	FROM	TO	PLUGGING INTERVALS
0	27	top soil			
27	66	sand and clay strips			
66	79	sand rock and sand strips			
79	94	sand fine and clay strips			
94	108	oker			
7 CONTRACTOR'S OR LANDOWNER'S CERTIFICATION: This water well was (1) constructed, (2) reconstructed, or (3) plugged under my jurisdiction and was completed on (mo/day/yr) <u>10-31-89</u> and this record is true to the best of my knowledge and belief. Kansas Water Well Contractor's License No. <u>139</u> This Water Well Record was completed on (mo/day/yr) <u>11-1-89</u> under the business name of <u>Bartell Drilling</u> by (signature) <u>Jay Bartell</u>					
INSTRUCTIONS: Use typewriter or ball point pen. PLEASE PRESS FIRMLY and PRINT clearly. Please fill in blanks, underline or circle the correct answers. Send two copies to Kansas Department of Health and Environment, Bureau of Water Protection, Topeka, Kansas 66620-7320. Telephone: 913-296-5514. Send one to WATER WELL OWNER and retain one for your records.					