

USE TYPEWRITER OR BALL POINT PEN-PRESS FIRMLY, PRINT CLEARLY.


WATER WELL RECORD
KSA 82a-1201-1215

Kansas Department of Health and Environment-Division of Environment (Water well Contractors) Topeka, Kansas 66620

000

1. Location of well: County Decatur Fraction SW 1/4 SW 1/4 SW 1/4 Section number 28 Township number T 3 S R 29 E 10

2. Distance and direction from nearest town or city: 2W-2 1/2 S-1/2 W-1/2 S
Street address of well location if in city: Obeslin
3. Owner of well: Ruby Deihl
R.R. or street:
City, state, zip code: Obeslin Ks 67749

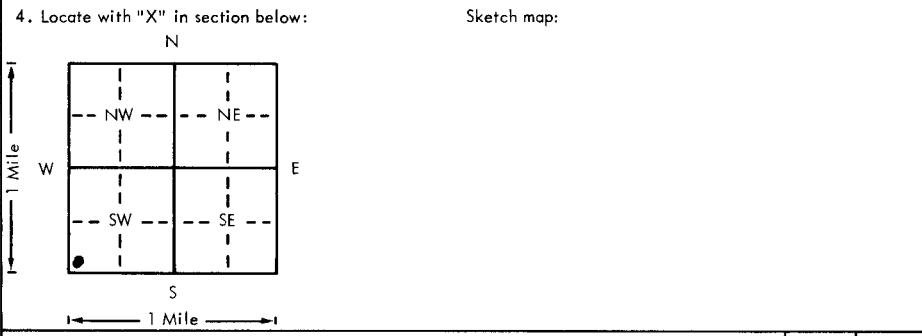

6. Bore hole dia. 30 in. Completion date 9-11-78
Well depth 52 ft.
7. Cable tool Rotary Driven Dug
 Hollow rod Jetted Bored Reverse rotary
8. Use: Domestic Public supply Industry
 Irrigation Air conditioning Stock
 Lawn Oil field water Other
9. Casing: Material Iron Height: Above or below
Threaded Welded Surface 32 in.
RMP PVC Weight lbs./ft.
Dia. 16 in. to 26 ft. depth Wall Thickness: inches or
Dia. in. to ft. depth Gauge No. 230

5. Type and color of material	From	To
<u>Top</u>	<u>0</u>	<u>17</u>
<u>Sand blue</u>	<u>17</u>	<u>26</u>
<u>sand</u>	<u>26</u>	<u>38</u>
<u>clay</u>	<u>38</u>	<u>39</u>
<u>Sand</u>	<u>39</u>	<u>51</u>
<u>shale</u>	<u>51</u>	<u>52</u>
<u>BROCK ST</u>		

10. Screen: Manufacturer's name Johnson
Type Transite Dia. 16"
Slot/gauze 1/8 Length 26 ft
Set between 36 ft. and 52 ft.
Gravel pack? Yes Size range of material 3/8-3/4
11. Static water level: 22 ft. below land surface Date 7-20-78 mo./day/yr.
12. Pumping level below land surfaces: 48 ft. after 6 hrs. pumping 420 g.p.m.
48 ft. after hrs. pumping g.p.m.
Estimated maximum yield 420 g.p.m.
13. Water sample submitted: mo./day/yr.
 Yes No Date
14. Well head completion: 32 Inches above grade
 Pitless adapter
15. Well grouted? Yes
With: Neat cement Bentonite Concrete
Depth: From 0 ft. to 10 ft.
16. Nearest source of possible contamination: 600 ft. Direction West Type creek
Well disinfected upon completion? Yes No
17. Pump: Not installed
Manufacturer's name Western Ind Rollco
Model number 677 HP 25 Volts 460
Length of drop pipe 48 ft. capacity 200 g.p.m.
Type: Submersible Turbine
 Jet Reciprocating
 Centrifugal Other

18. Elevation:
Topography: Hill Slope Upland Valley
19. Remarks:
(Use a second sheet if needed)

20. Water well contractor's certification:
This well was drilled under my jurisdiction and this report is true to the best of my knowledge and belief.
Sally Deihl 339
Business name Sally Deihl License No.
Address
Signed Date 10-2-78
Authorized representative

T 3
R 29
E 10
Sec 8
SW 1/4 SW 1/4 SW 1/4