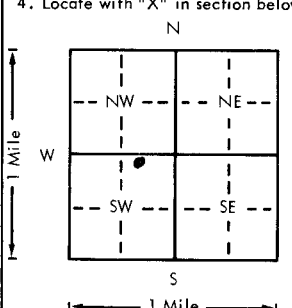


USE TYPEWRITER OR BALL POINT PEN-PRESS FIRMLY, PRINT CLEARLY.

WATER WELL RECORD
KSA 82a-1201-1215

Kansas Department of Health and Environment-Division of Environment (Water well Contractors) Topeka, Kansas 66620

C7B

1. Location of well: County <u>Decatur</u> Fraction <u>NW 1/4 NE 1/4 SW 1/4</u> Section number <u>28</u> Township number <u>T 3 S R 29 E 10</u>	
2. Distance and direction from nearest town or city: <u>2W-2 1/2 S-3W-1S 1/4 W Oberlin</u> 3. Owner of well: <u>Ruby Dehl</u> Street address of well location if in city: _____ R.R. or street: _____ City, state, zip code: <u>Oberlin Kans 67749</u>	
4. Locate with "X" in section below: Sketch map: 	
5. Type and color of material	
	From To
<u>Top</u>	<u>0 18</u>
<u>Soil blue</u>	<u>18 31</u>
<u>Soil + clay</u>	<u>31 36</u>
<u>Soil</u>	<u>36 52</u>
<u>Shale</u>	<u>52 52</u>
<u>BROCK 51'</u>	
(Use a second sheet if needed)	
18. Elevation: _____	19. Remarks: _____
20. Water well contractor's certification: This well was drilled under my jurisdiction and this report is true to the best of my knowledge and belief. <u>Jeddy Dunning</u> <u>339</u> Business name _____ License No. _____ Address <u>Jeddy R5</u> Signed <u>Ed Wagoner</u> Date <u>10-2-78</u> Authorized representative	

6. Bore hole dia. <u>30</u> in. Completion date <u>9-11-78</u> Well depth <u>52</u> ft.	
7. <input type="checkbox"/> Cable tool <input type="checkbox"/> Rotary <input type="checkbox"/> Driven <input type="checkbox"/> Dug <input type="checkbox"/> Hollow rod <input type="checkbox"/> Jetted <input type="checkbox"/> Bored <input checked="" type="checkbox"/> Reverse rotary	
8. Use: <input type="checkbox"/> Domestic <input type="checkbox"/> Public supply <input type="checkbox"/> Industry <input checked="" type="checkbox"/> Irrigation <input type="checkbox"/> Air conditioning <input type="checkbox"/> Stock <input type="checkbox"/> Lawn <input type="checkbox"/> Oil field water <input type="checkbox"/> Other	
9. Casing: Material <u>Iron</u> Height: <u>Above</u> or below Threaded <input checked="" type="checkbox"/> Welded _____ Surface <u>32</u> in. RMP _____ PVC _____ Weight _____ lbs./ft. Dia. <u>1 1/2</u> in. to <u>26</u> ft. depth Wall Thickness: inches or Dia. _____ in. to _____ ft. depth gage No. <u>250</u>	
10. Screen: Manufacturer's name <u>Johnson</u> Type <u>Transite</u> Dia. <u>16"</u> Slot/gauze <u>1/8</u> Length <u>26 ft</u> Set between <u>24</u> ft. and <u>52</u> ft. _____ ft. and _____ ft. Gravel pack? <u>Yes</u> Size range of material <u>3/8-3/4</u>	
11. Static water level: _____ mo./day/yr. <u>21</u> ft. below land surface Date <u>7-20-78</u>	
12. Pumping level below land surfaces: <u>48</u> ft. after <u>6</u> hrs. pumping <u>525</u> g.p.m. _____ ft. after _____ hrs. pumping _____ g.p.m. Estimated maximum yield <u>525</u> g.p.m.	
13. Water sample submitted: _____ mo./day/yr. <input type="checkbox"/> Yes <input checked="" type="checkbox"/> No Date _____	
14. Well head completion: _____ Pitless adapter <u>32</u> Inches above grade	
15. Well grouted? <u>Yes</u> With: _____ Neat cement <input checked="" type="checkbox"/> Bentonite _____ Concrete Depth: From <u>0</u> ft. to <u>10</u> ft.	
16. Nearest source of possible contamination: _____ ft. <u>300</u> Direction <u>S</u> Type <u>Lagoon</u> Well disinfected upon completion? <input type="checkbox"/> Yes <input checked="" type="checkbox"/> No	
17. Pump: _____ Not installed Manufacturer's name <u>Western Lumber</u> Model number <u>677</u> HP <u>30</u> Volts <u>440</u> Length of drop pipe <u>49</u> ft. capacity <u>350</u> g.p.m. Type: _____ Submersible <input checked="" type="checkbox"/> Turbine _____ Jet _____ Reciprocating _____ Centrifugal _____ Other	

T 3
R 29
E 10
Sec 28
NW NE SW
1/4 1/4 1/4