


1 LOCATION OF WATER WELL: Fraction SE 1/4 NW 1/4 SW 1/4 Section Number 1 Township Number T 3 S Range Number R 29 **(EW)**
 County: Decatur

Distance and direction from nearest town or city street address of well if located within city?
 209 South Rhodehaven

2 WATER WELL OWNER: City of Oberlin
 RR#, St. Address, Box # : 107 West Commercial Board of Agriculture, Division of Water Resources
 City, State, ZIP Code : Oberlin, KS 67749 Application Number:

3 LOCATE WELL'S LOCATION WITH AN "X" IN SECTION BOX:

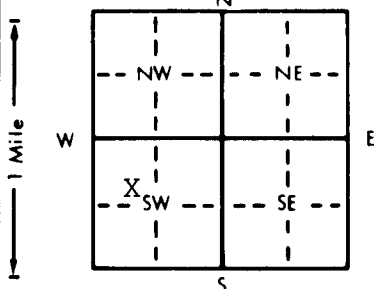

4 DEPTH OF COMPLETED WELL: 27 ft. ELEVATION:

Depth(s) Groundwater Encountered 1. 18.54 ft. 2. ft. 3. ft.
 WELL'S STATIC WATER LEVEL ft. below land surface measured on mo/day/yr
 Pump test data: Well water was ft. after hours pumping gpm
 Est. Yield gpm Well water was ft. after hours pumping gpm
 Bore Hole Diameter 8.25 in. to 27 ft., and in. to ft.
 WELL WATER TO BE USED AS:
 5 Public water supply 8 Air conditioning 11 Injection well
 1 Domestic 3 Feedlot 6 Oil field water supply 9 Dewatering 12 Other (Specify below)
 2 Irrigation 4 Industrial 7 Lawn and garden only **(10) Monitoring well**
 Was a chemical/bacteriological sample submitted to Department? Yes No **X**; If yes, mo/day/yr sample was sub-
 mitted Water Well Disinfected? Yes No **X**

5 TYPE OF BLANK CASING USED: 5 Wrought iron 8 Concrete tile CASING JOINTS: Glued Clamped
 1 Steel 3 RMP (SR) 6 Asbestos-Cement 9 Other (specify below) Welded
(2) PVC 4 ABS 7 Fiberglass **(Threaded)**

Blank casing diameter 2 in. to 12 ft., Dia. in. to ft., Dia. in. to ft.
 Casing height above land surface: Flush Mount in., weight lbs./ft. Wall thickness or gauge No. 0.308 inches
 TYPE OF SCREEN OR PERFORATION MATERIAL:
 1 Steel 3 Stainless steel 5 Fiberglass 8 RMP (SR) 10 Asbestos-cement
 2 Brass 4 Galvanized steel 6 Concrete tile 9 ABS 11 Other (specify)
 12 None used (open hole)

SCREEN OR PERFORATION OPENINGS ARE:
 1 Continuous slot **(3) Mill slot** 5 Gauzed wrapped 8 Saw cut 11 None (open hole)
 2 Louvered shutter 4 Key punched 6 Wire wrapped 9 Drilled holes
 7 Torch cut 10 Other (specify)

SCREEN-PERFORATED INTERVALS: From 12 ft. to 27 ft., From ft. to ft.
 From ft. to ft., From ft. to ft.
 GRAVEL PACK INTERVALS: From 10 ft. to 27 ft., From ft. to ft.
 From ft. to ft., From ft. to ft.

6 GROUT MATERIAL: 1 Neat cement **(2) Cement grout** **(3) Bentonite** 4 Other
 Grout Intervals: From 1 ft. to 8 ft., From 8 ft. to 10 ft., From ft. to ft.

What is the nearest source of possible contamination:
 1 Septic tank 4 Lateral lines 7 Pit privy 10 Livestock pens 14 Abandoned water well
 2 Sewer lines 5 Cess pool 8 Sewage lagoon 11 Fuel storage 15 Oil well/Gas well
 3 Watertight sewer lines 6 Seepage pit 9 Feedyard 12 Fertilizer storage **(16) Other (specify below)**
 dissolved product plume

Direction from well? Southwest How many feet? 40

FROM	TO	LITHOLOGIC LOG	FROM	TO	PLUGGING INTERVALS
0	2	Dark brown junk fill			
2	5	Dark brown silty clay fill			
5	13	Light brown silty clay			
13	18	Brown silty clay			
18	27	Brown silt			
		*fluch mount approved by Mr. Don Taylor of Kansas Department of Health and Environment			

7 CONTRACTOR'S OR LANDOWNER'S CERTIFICATION: This water well was **(1)** constructed, (2) reconstructed, or (3) plugged under my jurisdiction and was completed on (mo/day/year) 4-9-96 and this record is true to the best of my knowledge and belief, Kansas Water Well Contractor's License No. 540, 590 This Water Well Record was completed on (mo/day/yr) 4-20-96 under the business name of Liehs Drilling by (signature) Wesley G. Liehs