


1 LOCATION OF WATER WELL: County: Decatur Fraction: SE 1/4 NW 1/4 SW 1/4 Section Number: 1 Township Number: T 3 S Range Number: R 29 **EW**

Distance and direction from nearest town or city street address of well if located within city?
209 South Rhodehaven

2 WATER WELL OWNER: City of Oberlin
 RR#, St. Address, Box # : 107 West Commercial Board of Agriculture, Division of Water Resources
 City, State, ZIP Code : Oberlin, KS 67749 Application Number:

3 LOCATE WELL'S LOCATION WITH AN "X" IN SECTION BOX:

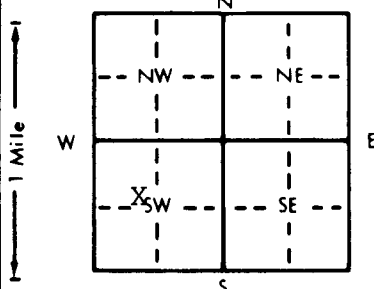

4 DEPTH OF COMPLETED WELL: 16 ft. ELEVATION:

Depth(s) Groundwater Encountered: 1 ft. N/A ft. 2. ft. 3. ft.
 WELL'S STATIC WATER LEVEL: 10.25 ft. below land surface measured on mo/day/yr
 Pump test data: Well water was _____ ft. after _____ hours pumping _____ gpm
 Est. Yield _____ gpm: Well water was _____ ft. after _____ hours pumping _____ gpm
 Bore Hole Diameter: 10.25 in. to 16.5 in. and _____ in. to _____ in.
 WELL WATER TO BE USED AS:
 1 Domestic 3 Feedlot 6 Oil field water supply 9 Dewatering 12 Other (Specify below) soil vapor extraction
 2 Irrigation 4 Industrial 7 Lawn and garden only 10 Monitoring well
 Was a chemical/bacteriological sample submitted to Department? Yes _____ No X; If yes, mo/day/yr sample was submitted _____
 Water Well Disinfected? Yes _____ No X

5 TYPE OF BLANK CASING USED:
 1 Steel 3 RMP (SR) 5 Wrought iron 8 Concrete tile CASING JOINTS: Glued _____ Clamped _____
 2 PVC 4 ABS 7 Fiberglass Welded _____
 Blank casing diameter: 4 in. to 6 ft., Dia _____ in. to _____ ft., Dia _____ in. to _____ ft.
 Casing height above land surface: Flush mount in., weight _____ lbs./ft. Wall thickness or gauge No. 0.308 inches

TYPE OF SCREEN OR PERFORATION MATERIAL:
 1 Steel 3 Stainless steel 5 Fiberglass 7 PVC 10 Asbestos-cement
 2 Brass 4 Galvanized steel 6 Concrete tile 8 RMP (SR) 11 Other (specify) _____
 SCREEN OR PERFORATION OPENINGS ARE:
 1 Continuous slot 3 Mill slot 5 Gauzed wrapped 8 Saw cut 11 None (open hole)
 2 Louvered shutter 4 Key punched 6 Wire wrapped 9 Drilled holes
 7 Torch cut 10 Other (specify) _____

SCREEN-PERFORATED INTERVALS: From 6 ft. to 16 ft., From _____ ft. to _____ ft.
 From _____ ft. to _____ ft., From _____ ft. to _____ ft.
 GRAVEL PACK INTERVALS: From 5 ft. to 16.5 ft., From _____ ft. to _____ ft.
 From _____ ft. to _____ ft., From _____ ft. to _____ ft.

6 GROUT MATERIAL: 1 Neat cement 2 Cement grout 3 Bentonite 4 Other _____
 Grout Intervals: From 1 ft. to 4 ft., From 4 ft. to 5 ft., From _____ ft. to _____ ft.
 What is the nearest source of possible contamination:
 1 Septic tank 4 Lateral lines 7 Pit privy 10 Livestock pens 14 Abandoned water well
 2 Sewer lines 5 Cess pool 8 Sewage lagoon 11 Fuel storage 15 Oil well/Gas well
 3 Watertight sewer lines 6 Seepage pit 9 Feedyard 12 Fertilizer storage 16 Other (specify below) Dissolved product plume

Direction from well? installed within plume
 How many feet? 0

FROM	TO	LITHOLOGIC LOG	FROM	TO	PLUGGING INTERVALS
0	1	Light brown junk fill			
1	6	Black silty clay			
6	16.5	Light brown silt			
		*flush mount approved by Mr. Don Taylor of Kansas Department of Health and Environment			

7 CONTRACTOR'S OR LANDOWNER'S CERTIFICATION: This water well was (1) constructed, (2) reconstructed, or (3) plugged under my jurisdiction and was completed on (mo/day/year) 4-10-96 and this record is true to the best of my knowledge and belief. Kansas Water Well Contractor's License No. 590. This Water Well Record was completed on (mo/day/yr) 4-20-96 under the business name of Liehs Drilling by (signature) Wesley G. Liehs