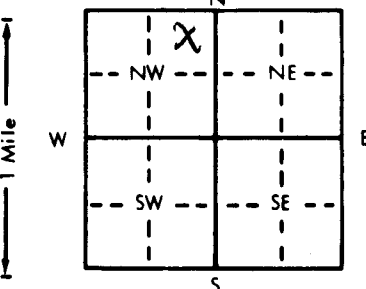


1 LOCATION OF WATER WELL:		Fraction	Section Number	Township Number	Range Number
County: Decatur		$\frac{1}{4}$ Ne $\frac{1}{4}$ SW $\frac{1}{4}$	7	T 3 S	R 29 E/W
Distance and direction from nearest town or city street address of well if located within city? 5 Miles west of Oberlin					
2 WATER WELL OWNER: John Schultz RR#, St. Address, Box # : City, State, ZIP Code : Oberlin, Kansas Board of Agriculture, Division of Water Resources Application Number:					
3 LOCATE WELL'S LOCATION WITH AN "X" IN SECTION BOX:		4 DEPTH OF COMPLETED WELL: 82 ft. ELEVATION: 62 ft.			
		Depth(s) Groundwater Encountered 1. 62 ft. 2. ft. 3. ft.			
		WELL'S STATIC WATER LEVEL 62 ft. below land surface measured on mo/day/yr			
		Pump test data: Well water was ft. after hours pumping gpm			
		Est. Yield 5 gpm Well water was ft. after hours pumping gpm			
		Bore Hole Diameter 8 in. to 82 ft., and in. to ft.			
		WELL WATER TO BE USED AS:			
		5 Public water supply 8 Air conditioning 11 Injection well			
		1 Domestic 3 Feedlot 6 Oil field water supply 9 Dewatering 12 Other (Specify below)			
		2 Irrigation 4 Industrial 7 Lawn and garden only 10 Observation well			
		Was a chemical/bacteriological sample submitted to Department? Yes.....No X; If yes, mo/day/yr sample was submitted			
		Water Well Disinfected? Yes No			
5 TYPE OF BLANK CASING USED:					
1 Steel 3 RMP (SR) 5 Wrought iron 8 Concrete tile CASING JOINTS: Glued X Clamped					
2 PVC 4 ABS 6 Asbestos-Cement 9 Other (specify below) Welded					
7 Fiberglass Threaded					
Blank casing diameter 5 in. to 72 ft., Dia. in. to ft., Dia. in. to ft.					
Casing height above land surface 12 in., weight lbs./ft. Wall thickness or gauge No. 258					
TYPE OF SCREEN OR PERFORATION MATERIAL:					
1 Steel 3 Stainless steel 5 Fiberglass 8 RMP (SR) 10 Asbestos-cement					
2 Brass 4 Galvanized steel 6 Concrete tile 9 ABS 11 Other (specify)					
12 None used (open hole)					
SCREEN OR PERFORATION OPENINGS ARE:					
5 Gauzed wrapped 8 Saw cut 11 None (open hole)					
1 Continuous slot 3 Mill slot 6 Wire wrapped 9 Drilled holes					
2 Louvered shutter 4 Key punched 7 Torch cut 10 Other (specify)					
SCREEN-PERFORATED INTERVALS: From 82 ft. to 72 ft., From ft. to ft.					
From ft. to ft., From ft. to ft.					
GRAVEL PACK INTERVALS: From 82 ft. to 15 ft., From ft. to ft.					
From ft. to ft., From ft. to ft.					
6 GROUT MATERIAL: 1 Neat cement 2 Cement grout 3 Bentonite 4 Other					
Grout Intervals: From 15 ft. to 5 ft., From ft. to ft., From ft. to ft.					
What is the nearest source of possible contamination: For Pitless Adapter 10 Livestock pens 14 Abandoned water well					
1 Septic tank 4 Lateral lines 7 Pit privy 11 Fuel storage 15 Oil well/Gas well					
2 Sewer lines 5 Cess pool 8 Sewage lagoon 12 Fertilizer storage 16 Other (specify below)					
3 Watertight sewer lines 6 Seepage pit 9 Feedyard 13 Insecticide storage					
Direction from well? South How many feet? 100					
FROM	TO	LITHOLOGIC LOG	FROM	TO	LITHOLOGIC LOG
top	45	top soil and clay			
45	69	sand stone			
69	77	sand			
77	82	clay			
81	82	Fine sand			
82		shale			
7 CONTRACTOR'S OR LANDOWNER'S CERTIFICATION: This water well was (1) constructed, (2) reconstructed, or (3) plugged under my jurisdiction and was completed on (mo/day/year) 9-16-81 and this record is true to the best of my knowledge and belief. Kansas					
Water Well Contractor's License No. 398 This Water Well Record was completed on (mo/day/yr) 10-14-81					
under the business name of Kelley Drilling Co. by (signature) Richard C. Kelley					
INSTRUCTIONS: Use typewriter or ball point pen, PLEASE PRESS FIRMLY and PRINT clearly. Please fill in blanks, underline or circle the correct answers. Send top three copies to Kansas Department of Health and Environment, Division of Environment, Environmental Geology Section, Topeka, KS 66620. Send one to WATER WELL OWNER and retain one for your records.					