


1	LOCATION OF WATER WELL:	Fraction	Section Number	Township Number	Range Number
County:	Decatur	SE 1/4 NW 1/4 SW 1/4	1	T3S	29

Distance and direction from nearest town or city street address of well if located within city?
 205 South Rhodehaven

2	WATER WELL OWNER:	Arthur Hamilton c/o Rhon Hamilton	Board of Agriculture, Division of Water Resources
	RR #, St. Address, Box #:	12 Huntington Rd	Application Number: MW1
	City, State, ZIP Code :	Augusta, KS 67010	

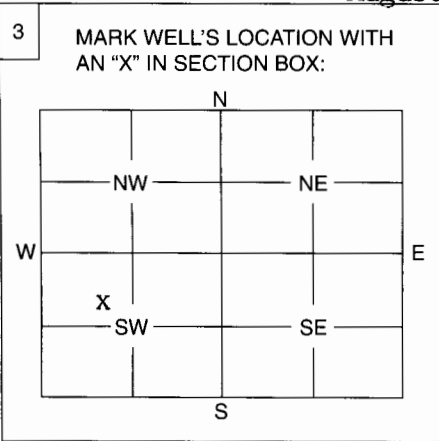

4	DEPTH OF WELL	26.48	ft.
	WELL'S STATIC WATER LEVEL	23.80	ft.
	WELL WAS USED AS:		
	1 Domestic	5 Public Water Supply	9 Dewatering
	2 Irrigation	6 Oil Field Water Supply	<input checked="" type="checkbox"/> 10 Monitoring Well MW-1
	3 Feedlot	7 Domestic (Lawn & Garden)	11 Injection Well
	4 Industrial	8 Air Conditioning	12 Other
	Was a chemical / bacteriological sample submitted to Department? Yes No <input checked="" type="checkbox"/> X		
	If yes, mo/day/yr sample was submitted		
	Water Well Disinfected: Yes No <input checked="" type="checkbox"/> X		

5	TYPE OF BLANK CASING USED:	
	1 Steel	3 RMP (SR)
	<input checked="" type="checkbox"/> 2 PVC	4 ABS
	5 Wrought	6 Asbestos-Cement
	7 Fiberglass	8 Concrete Tile
	9 Other (Specify below)	
	Blank casing diameter	2 in.
	Was casing pulled?	Yes <input checked="" type="checkbox"/> X No
	Casing height above or below land surface	removed in.
	If yes, how much	26.5'

6	GROUT PLUG MATERIAL:	1 Neat cement	2 Cement grout	<input checked="" type="checkbox"/> 3 Bentonite	4 Other
	GROUT PLUG INTERVALS:	From 0 ft.	to 1 ft.,	From 1 ft.	to 20 ft.,
	What is the nearest source of possible contamination:				
	1 Septic tank	6 Seepage pit	<input checked="" type="checkbox"/> 11 Fuel storage	16 Other (specify below)	
	2 Sewer lines	7 Pit privy	12 Fertilizer storage		
	3 Watertight sewer lines	8 Sewage lagoon	13 Insecticide storage		
	4 Lateral lines	9 Feedyard	14 Abandoned water well		
	5 Cess pool	10 Livestock pens	15 Oil well/Gas well		
	Direction from well?	North	How many feet?	250	

FROM	TO	PLUGGING MATERIALS
0	1	Asphalt
1	20	Volclay 20 0/0 Bentonite Grout

7 CONTRACTOR'S OF LANDOWNER'S CERTIFICATION: This water well was plugged under my jurisdiction and was completed on (mo/day/year) 9-16-05 and this record is true to the best of my knowledge and belief. Kansas Water Well Contractor's License No. 735 This Water Well Record was completed on (mo/day/year) under the business name of MILCO Environmental Services, Inc. by (signature) [Signature]

INSTRUCTIONS: Use typewriter or ball point pen. Please press firmly and print clearly. Please fill in blanks, underline or circle the correct answers. Send top three copies to Kansas Department of Health and Environment, Bureau of Water, Geology Section, 1000 SW Jackson St., Ste. 420, Topeka, Kansas 66612-1367. Telephone: 785/296-5522. Send one to Water Well Owner and retain one for your records.