

CORRECTED

WATER WELL PLUGGING RECORD Form WWC-5P KSA 82a-1212 ID NO.

MW1A

1 LOCATION OF WATER WELL: Fraction NE 1/4 NE 1/4 NE 1/4 Section Number 2 Township Number T 3 S Range Number 29 E X W

Street/Rural Address of Well Location; if unknown, distance & direction from nearest town or intersection: If at owner's address, check here


Global Positioning Systems (GPS) information: Latitude: NA Longitude: NA Elevation: NA

504 W. Frontier Parkway, Oberlin, KS

Horizontal Datum: WGS84, NAD83, NAD27

2 WATER WELL OWNER: Kathka, Elmer RR#, St. Address, Box #: 712 E. Commercial St. City, State ZIP Code: Oberlin, KS 67749

Collection Method: GPS unit, Digital Map/Photo, Topographic Map, Land Survey Est. Accuracy: <3 m, 3-5 m, 5-15 m, >15 m

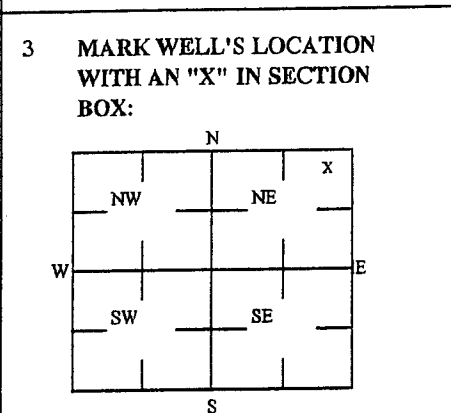

4 DEPTH OF WELL 102.1 ft. MW1A WELL'S STATIC WATER LEVEL ft. WELL WAS USED AS: Domestic, Irrigation, Feedlot, Industrial, Public Water Supply, Oil Field Water Supply, Domestic (Lawn & Garden), Air Conditioning, Dewatering, Monitoring, Injection Well, Other

5 TYPE OF BLANK CASING USED: Steel, PVC, RMP (SR), ABS, Wrought, Asbestos-Cement, Fiberglass, Concrete Tile, Other (Specific below) Blank casing diameter 2 in. Was casing pulled? Yes No X If yes, how much

6 GROUT PLUG MATERIAL: Neat cement, Cement grout, Bentonite, Other Concrete: 0-1; Flowable fill: 9-102.1' Grout Plug Intervals: From 1 ft to 9 ft, From ft to ft, From ft to ft, What is the nearest source of possible contamination: Septic tank, Sewer lines, Watertight sewer lines, Lateral lines, Cess pool, Seepage pit, Pit privy, Sewage lagoon, Feed yard, Livestock pens, Fuel storage, Fertilizer storage, Insecticide storage, Abandoned water well, Oil well/Gas well, Other (specify below)

Table with columns: FROM, TO, PLUGGING MATERIALS. Rows: 0-1 Concrete, 1-9 Bentonite, 9-102.1 Flowable fill. Includes KDHE ID: Fifth Wheel, Inc.; U6-020-00467

7 CONTRACTOR'S OR LANDOWNER'S CERTIFICATION: This water well was plugged under my jurisdiction and was completed on (mo/day/year) 1/11-12/16 and this record is true to the best of my knowledge and belief. Kansas Water Contractor's License No. 757. This Water Well Record was completed on (mo/day/year) 2/4/2016 under the business name of Larsen & Associates, Inc. By (signature)