

CORRECTED

WATER WELL PLUGGING RECORD Form WWC-5P KSA 82a-1212 ID NO.

MW4A

1 LOCATION OF WATER WELL: Fraction NE 1/4 NE 1/4 NE 1/4 Section Number 2 Township Number T 3 S Range Number 29 E X W

County: Decatur Street/Rural Address of Well Location; if unknown, distance & direction from nearest town or intersection: If at owner's address, check here


Global Positioning Systems (GPS) information: Latitude: NA (in decimal degrees) Longitude: NA (in decimal degrees) Elevation: NA

504 W. Frontier Parkway, Oberlin, KS

Horizontal Datum: [] WGS84, [] NAD83, [] NAD27 Collection Method: [] GPS unit (Make/model), [] Digital Map/Photo, [] Topographic Map, [] Land Survey

2 WATER WELL OWNER: Kathka, Elmer RR#, St. Address, Box #: 712 E. Commercial St. City, State ZIP Code: Oberlin, KS 67749

Est. Accuracy: [] <3 m, [] 3-5 m, [] 5-15 m, [] >15 m

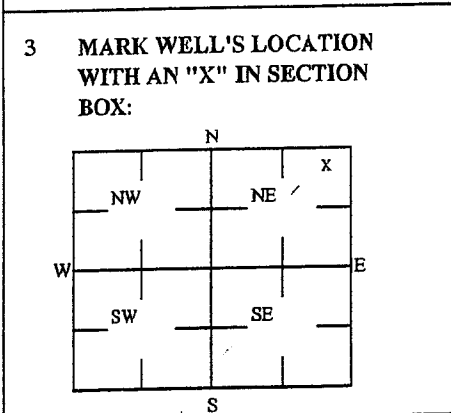

4 DEPTH OF WELL 105.05 ft. MW4A WELL'S STATIC WATER LEVEL ft. WELL WAS USED AS: [] Domestic, [] Irrigation, [] Feedlot, [] Industrial, [] Public Water Supply, [] Oil Field Water Supply, [] Domestic (Lawn & Garden), [] Air Conditioning, [] Dewatering, [X] Monitoring, [] Injection Well, [] Other. Was a chemical/bacteriological sample submitted to Department? Yes [] No [X]

5 TYPE OF BLANK CASING USED: [X] Steel, [] RMP (SR), [] Wrought, [] Fiberglass, [] Other (Specific below), [] PVC, [] ABS, [] Asbestos-Cement, [] Concrete Tile. Blank casing diameter 2 in. Was casing pulled? Yes [X] No [] If yes, how much 3' Casing height above or below land surface NA in.

6 GROUT PLUG MATERIAL: [] Neat cement, [] Cement grout, [X] Bentonite, [X] Other Soil: 0-1; Flowable fill: 3-105.05' Grout Plug Intervals: From 1 ft to 3 ft, From ft to ft, From ft to ft. What is the nearest source of possible contamination: [] Septic tank, [] Sewer lines, [] Watertight sewer lines, [] Lateral lines, [] Cess pool, [] Seepage pit, [] Pit privy, [] Sewage lagoon, [] Feed yard, [] Livestock pens, [] Fuel storage, [] Fertilizer storage, [] Insecticide storage, [] Abandoned water well, [] Oil well/Gas well, [] Other (specify below). Direction from well? How many feet?

Table with columns: FROM, TO, PLUGGING MATERIALS. Rows: 0 to 1 Soil, 1 to 3 Bentonite, 3 to 105.05 Flowable fill. Includes KDHE ID: Fifth Wheel, Inc.; U6-020-00467

7 CONTRACTOR'S OR LANDOWNER'S CERTIFICATION: This water well was plugged under my jurisdiction and was completed on (mo/day/year) 1/11-12/16 and this record is true to the best of my knowledge and belief. Kansas Water Contractor's License No. 757. This Water Well Record was completed on (mo/day/year) 2/4/2016 under the business name of Larsen & Associates, Inc. By (signature)