

CORRECTED

WATER WELL PLUGGING RECORD Form WWC-5P KSA 82a-1212 ID NO.

MW6


1 LOCATION OF WATER WELL: Fraction NE 1/4 NE 1/4 NE 1/4 NE 1/4 Section Number 2 Township Number T 3 S Range Number 29 E X W

County: Decatur Street/Rural Address of Well Location; if unknown, distance & direction from nearest town or intersection: If at owner's address, check here

Global Positioning Systems (GPS) information: Latitude: NA Longitude: NA Elevation: NA Horizontal Datum WGS84 NAD83 NAD27

504 W. Frontier Parkway, Oberlin, KS 2 WATER WELL OWNER: Kathka, Elmer RR#, St. Address, Box #: 712 E. Commercial St. City, State ZIP Code: Oberlin, KS 67749

Collection Method: GPS unit (Make/model): Digital Map/Photo Topographic Map Land Survey Est. Accuracy: <3 m, 3-5 m, 5-15 m, >15 m

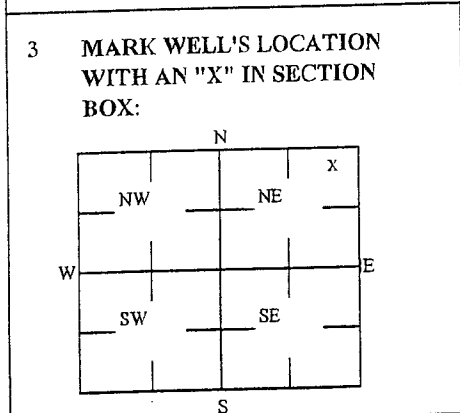

4 DEPTH OF WELL 105.16 ft. MW6 WELL'S STATIC WATER LEVEL ft. WELL WAS USED AS: Domestic Irrigation Feedlot Industrial Public Water Supply Oil Field Water Supply Domestic (Lawn & Garden) Air Conditioning Dewatering Monitoring Injection Well Other Was a chemical/bacteriological sample submitted to Department? Yes No

5 TYPE OF BLANK CASING USED: Steel PVC RMP (SR) ABS Wrought Asbestos-Cement Fiberglass Concrete Tile Other (Specific below) Blank casing diameter 2 in. Casing height above or below land surface NA in. Was casing pulled? Yes No If yes, how much 3'

6 GROUT PLUG MATERIAL: Neat cement Cement grout Bentonite Other Soil: 0-1; Flowable fill: 9-105.16' Grout Plug Intervals: From 1 ft to 9 ft, From ft to ft, From ft to ft. What is the nearest source of possible contamination: Septic tank Sewer lines Watertight sewer lines Lateral lines Cess pool Seepage pit Pit privy Sewage lagoon Feed yard Livestock pens Fuel storage Fertilizer storage Insecticide storage Abandoned water well Oil well/Gas well Other (specify below) Direction from well? How many feet?

Table with columns: FROM, TO, PLUGGING MATERIALS. Rows: 0 to 1 Soil, 1 to 9 Bentonite, 9 to 105.16 Flowable fill. KDHE ID: Fifth Wheel, Inc.; U6-020-00467

7 CONTRACTOR'S OR LANDOWNER'S CERTIFICATION: This water well was plugged under my jurisdiction and was completed on (mo/day/year) 1/11-12/16 and this record is true to the best of my knowledge and belief. Kansas Water Contractor's License No. 757. This Water Well Record was completed on (mo/day/year) 2/4/2016 under the business name of Larsen & Associates, Inc. By (signature)

Send one white copy to Kansas Department of Health & Environment, Geology Section, 1000 SW Jackson Street, Ste. 420, Topeka, KS 66612-1367. Send one copy to WATER WELL OWNER and retain one for your records. Visit us at http://www.kdheks.gov/waterwell/index.html Telephone 785-296-5524.