


1 LOCATION OF WATER WELL: Fraction NW 1/4 NE 1/4 NW 1/4 Section Number 11 Township Number T 3 S Range Number R 3 E

County: Republic Distance and direction from nearest town or city street address of well if located within city? 1433 28th Street, Bellville, Kansas

2 WATER WELL OWNER: George Jensen RR#, St. Address, Box #: R.R. 2, P.O. Box 7 City, State, ZIP Code: Mankato, Kansas 67401 Board of Agriculture, Division of Water Resources Application Number:

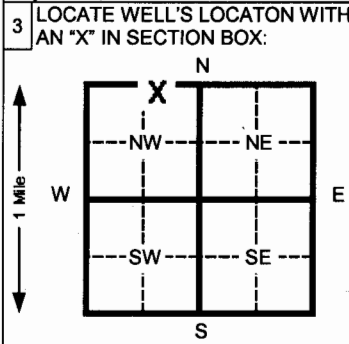

4 DEPTH OF COMPLETED WELL 23.0 ft. ELEVATION: Depth(s) Groundwater Encountered 1 22.0 ft. 2 ft. 3 ft. WELL'S STATIC WATER LEVEL 22.27 ft. below land surface measured on mo/day/yr 08/29/06 Pump test data: Well water was ft. after hours pumping gpm Est. Yield NA gpm: Well water was ft. after hours pumping gpm Bore Hole Diameter 8.5 in. to 23.0 ft. and in. to ft. WELL WATER TO BE USED AS: 5 Public water supply 8 Air conditioning 11 Injection well 1 Domestic 3 Feed lot 6 Oil field water supply 9 Dewatering 12 Other (Specify below) 2 Irrigation 4 Industrial 7 Lawn and garden (domestic) 10 Monitoring well Was a chemical/bacteriological sample submitted to Department? Yes No X If yes, mo/day/yr sample was submitted Water Well Disinfected? Yes No X

5 TYPE OF BLANK CASING USED: 1 Steel 3 RMP (SR) 5 Wrought Iron 8 Concrete tile CASING JOINTS: Glued Clamped 2 PVC 4 ABS 6 Asbestos-Cement 9 Other (specify below) Welded 7 Fiberglass Threaded X Blank casing diameter 2.375 in. to 8.0 ft., Dia in. to ft., Dia in. to ft. Casing height above land surface Flush Mount in., weight lbs./ft. Wall thickness or gauge No. Schedule 40 TYPE OF SCREEN OR PERFORATION MATERIAL: 1 Steel 3 Stainless steel 5 Fiberglass 7 PVC 10 Asbestos-cement 2 Brass 4 Galvanized steel 6 Concrete tile 8 RMP (SR) 11 Other (specify) 12 None used (open hole) SCREEN OR PERFORATION OPENINGS ARE: 1 Continuous slot 2 Louvered shutter 3 Mill slot 4 Key punched 5 Gauzed wrapped 6 Wire wrapped 8 Saw cut 11 None (open hole) 7 Torch cut 9 ABS 10 Other (specify) SCREEN-PERFORATED INTERVALS: From 23.0 ft. to 8.0 ft. From ft. to ft. From ft. to ft. GRAVEL PACK INTERVALS: From 23.0 ft. to 5.5 ft. From ft. to ft. From ft. to ft.

6 GROUT MATERIAL: 1 Neat cement 2 Cement grout 3 Bentonite 4 Other Grout Intervals From 0.0 ft. to 1.5 ft. From 1.5 ft. to 5.5 ft. From ft. to ft. What is the nearest source of possible contamination: 1 Septic tank 4 Lateral lines 7 Pit privy 10 Livestock pens 14 Abandoned water well 2 Sewer lines 5 Cess pool 8 Sewage lagoon 11 Fuel storage (former) 15 Oil well/ Gas well 3 Watertight sewer lines 6 Seepage pit 9 Feedyard 12 Fertilizer storage 16 Other (specify below) 13 Insecticide storage Direction from well? North How many feet? 290

FROM	TO	CODE	LITHOLOGIC LOG
0.0	0.5		Gravel
0.5	7.5		Brown-dark brown very silty clay, laminated, very firm, moist
7.5	12.5		Light brown very silty clay, very firm, moist-very moist
12.5	18.5		Red-brown very silty clay, very firm, moist-very moist
18.5	23.0		Tan, light red-brown very silty clay, sandy, some sandstone fragments, firm, very moist-wet
Flush-mount well completion waiver existent for site.			

7 CONTRACTOR'S OR LANDOWNER'S CERTIFICATION: This water well was (1) constructed, (2) reconstructed, or (3) plugged under my jurisdiction and was completed on (mo/day/yr) 08/28/06 and this record is true to the best of my knowledge and belief. Kansas Water Well Contractor's License No. 692 This Water Well Record was completed on (mo/day/yr) 09/03/06 under the business name of Quad State Services, Inc. by (signature)

INSTRUCTIONS: Please fill in blanks and circle the correct answers. Send three copies to Kansas Department of Health and Environment, Bureau of Water, 1000 S.W. Jackson St., Ste. 420, Topeka, Kansas 66612-1367. Telephone: 913-296-5545. Send one to WATER WELL OWNER and retain one for your records.

OFFICE USE ONLY

T

R

SEC