


1 LOCATION OF WATER WELL: County: Republic Fraction NE ¼ ¼ Section Number 34 Township Number 3 Range Number 3 EW

Distance and direction from nearest town or city street address of well if located within city?
4 miles South on Hwy 81 1/2 mile East on Shady Rd From Belleville KS

2 WATER WELL OWNER: Wes Walenta
 RR#, St. Address, Box #: 64 TALMO DR.
 City, State ZIP Code: Belleville KS 66935

Global Positioning Systems (decimal degrees, min. of 4 digits)
 Latitude: _____
 Longitude: _____
 Elevation: _____
 Datum: _____
 Data Collection Method: _____

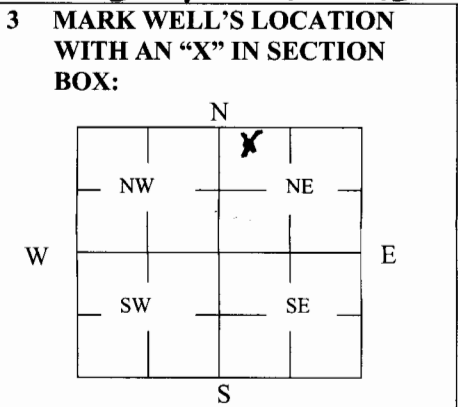

4 DEPTH OF WELL 30 ft.
 WELL'S STATIC WATER LEVEL 0 ft.
 WELL WAS USED AS:
 1 Domestic 5 Public Water Supply 9 Dewatering
 2 Irrigation 6 Oil Field Water Supply 10 Monitoring
 3 Feedlot 7 Domestic (Lawn & Garden) 11 Injection Well
 4 Industrial 8 Air Conditioning 12 Other _____

Was a chemical/bacteriological sample submitted to Department? Yes _____ No _____

5 TYPE OF BLANK CASING USED:
 1 Steel 3 RMP (SR) 5 Wrought 7 Fiberglass 9 Other (Specify below) _____
 2 PVC 4 ABS 6 Asbestos-Cement 8 Concrete Tile

Blank casing diameter 6 in. Was casing pulled? Yes _____ No If yes, how much _____
 Casing height above or below and surface 48 in.

6 GROUT PLUG MATERIAL: 1 Neat cement 2 Cement grout 3 Bentonite 4 Other _____

Grout Plug Intervals: From 0 ft. to 30 ft., From _____ ft. to _____ ft., From _____ to _____ ft.

What is the nearest source of possible contamination:
 1 Septic tank 6 Seepage pit 11 Fuel Storage 16 Other (specify below) _____
 2 Sewer lines 7 Pit privy 12 Fertilizer storage _____
 3 Watertight sewer lines 8 Sewage lagoon 13 Insecticide storage _____
 4 Lateral lines 9 Feedyard 14 Abandoned water well Direction from well? West
 5 Cess pool 10 Livestock pens 15 Oil well/Gas well How many feet? 2640

FROM	TO	PLUGGING MATERIALS	FROM	TO	PLUGGING MATERIALS
0	30 FT	Cement			

7 CONTRACTOR'S OR LANDOWNER'S CERTIFICATION: This water well was plugged under my jurisdiction and was completed on (mo/day/year) 11-6-2010 and this record is true to the best of my knowledge and belief. Kansas Water Well Contractor's License No. _____. This Water Well Record was completed on (mo/day/year) 11-14-10 under the business name of _____ by (signature) Wes Walenta