

Revised

TRITERRA

LAND SERVICES

P.O. Box 546
Clearwater, Kansas 67026
Cell (316) 648-3617 Fax (620) 584-4371
Email: triterrals@yahoo.com


SURVEYING OF MONITORING WELLS SWIERCINSKY BROTHERS (FORMER) BELLEVILLE, KANSAS

The above site is in Section 2, Township 3 South, Range 3 West of the Sixth Principal Meridian, Republic County, Kansas. The Southeast corner of Section 2 was assigned coordinates of 00.00 North and 00.00 West.

The top of casing elevation from MW-10 of an adjacent site, Double Circle Farm Supply, was used for vertical control. A Control Point was established as a chiseled 'X' on the end of the sidewalk at the northwest corner of the site.

The Latitude and Longitude were recorded from a GPS unit. The site is located on the 7.5' quad map titled "Belleville".

ID	NORTH	WEST	LATITUDE	LONGITUDE	ELEVATION
SE CORNER 2-3S-3W	00.00	00.00			
Control Point	4830.74	4617.79	39.82605	97.63091	1540.31
MW-1 SW NE NW NW	4724.97	4612.96	39.82574	97.63087	RIM 1541.23 TOC 1540.73
MW-2 SE NW NW NW	4809.71	4623.08	39.82597	97.63091	RIM 1540.48 TOC 1540.01
MW-3 SE NW NW NW	4712.50	4741.97	39.82571	97.63132	RIM 1540.82 TOC 1540.61
MW-4 SE NW NW NW	4648.78	4630.60	39.82554	97.63097	RIM 1541.70 TOC 1541.48
MW-5 SE NW NW NW	4834.78	4741.66	39.82603	97.63132	RIM 1540.22 TOC 1539.77
MW-6 SE NW NW NW	4889.74	4621.56	39.82617	97.63091	RIM 1539.78 TOC 1539.45
MW-7 SW NE NW NW	4853.05	4493.33	39.82608	97.63046	RIM 1541.22 TOC 1540.80
MW-8 SE NW NW NW	4648.22	4706.59	39.82552	97.63120	RIM 1542.93 TOC 1542.54
MW-9 SE NW NW NW	4907.72	4771.67	39.82626	97.63143	RIM 1539.33 TOC 1538.62

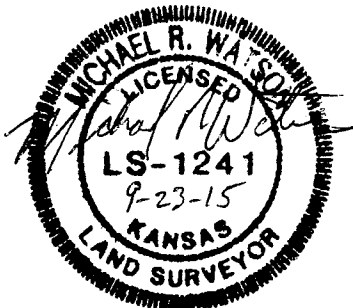

WATER WELL RECORD

Form WWC-5

Division of Water Resources App. No.

Well ID

MW9

Original Record Correction Change in Well Use

1 LOCATION OF WATER WELL: County Republic Section Number Township Number Range Number

2 WELL OWNER: Last Name: Business: Address: City State ZIP: Street or Rural Address where well is located

3 LOCATE WELL WITH 'X' IN SECTION BOX: 4 DEPTH OF COMPLETED WELL: 5 Latitude: Longitude: Horizontal Datum: Source for Latitude/Longitude: 6 Elevation: Source

7 WELL WATER TO BE USED AS: 1 Domestic: 2 Irrigation: 3 Feedlot: 4 Industrial: 5 Public Water Supply: well ID: 6 Dewatering: how many wells?: 7 Aquifer Recharge: well ID: 8 Monitoring: well ID MW9: 9 Environmental Remediation: well ID: 10 Oil Field Water Supply: lease: 11 Test Hole: well ID: 12 Geothermal: How many bores?:

Was a chemical/bacteriological sample submitted to KDHE? Water well disinfected?

8 TYPE OF CASING USED: CASING JOINTS: TYPE OF SCREEN OR PERFORATION MATERIAL: SCREEN OR PERFORATION OPENINGS ARE: SCREEN-PERFORATED INTERVALS: GRAVEL PACK INTERVALS:

9 GROUT MATERIAL: Grout intervals:

Nearest source of possible contamination: Direction from well? Distance from well?

Table with columns: FROM, TO, LITHOLOGIC LOG, FROM, TO, LITHO. LOG (cont.) or PLUGGING INTERVALS

Notes: KDHE ID: Swiercinsky Brothers (former); U5-079-14713

11 CONTRACTOR'S OR LANDOWNER'S CERTIFICATION: This water well was constructed, reconstructed, or plugged under my jurisdiction and was completed on (mo-day-year) 9/10/15 and this record is true to the best of my knowledge and belief.