

WATER WELL RECORD

Form WWC-5

Division of Water Resources App. No.


Well ID

MW13

Original Record Correction Change in Well Ust

1 LOCATION OF WATER WELL: County Republic Fraction SW 1/4 NE 1/4 NW 1/4 SE 1/4 Section Number 2 Township Number 3 Range Number 3 E W

2 WELL OWNER: Last Name: First: Street or Rural Address where well is located (if unknown, distance and direction from nearest town or intersection): If at owner's address, check here: Business: Kansas Department of Health and Environment Address: 1000 SW Jackson, Suite 410 City: Topeka State: KS ZIP: 66612

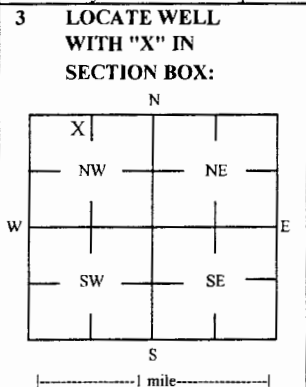

3 LOCATE WELL WITH 'X' IN SECTION BOX: 4 DEPTH OF COMPLETED WELL: 21.79 ft Depth(s) Groundwater Encountered: 1) \_\_\_\_\_ ft 2) \_\_\_\_\_ ft 3) \_\_\_\_\_ ft, or 4) Dry Well WELL'S STATIC WATER LEVEL: 17.1 ft below land surface, measured on (mo-day-yr) 2/9-10/16

5 Latitude: 39.82609 (decimal degrees) Longitude: 97.63003 (decimal degrees) Horizontal Datum: WGS 84 NAD 83 NAD 27 Source for Latitude/Longitude: GPS (unit make/model): (WAAS enabled? Yes No) Land Survey Topographic Map Online Mapper

6 Elevation 1540.84 ft Ground Level TOC Source Land Survey GPS Topographic Map Other

7 WELL WATER TO BE USED AS: 1 Domestic: Household Lawn & Garden Livestock Irrigation Feedlot Industrial 5 Public Water Supply: well ID 6 Dewatering: how many wells? 7 Aquifer Recharge: well ID 8 Monitoring: well ID MW13 9 Environmental Remediation: well ID Air Sparge Soil Vapor Extractor Recovery Injection 10 Oil Field Water Supply: lease 11 Test Hole: well ID Cased Uncased Geotechnical 12 Geothermal: How many bores? a) Closed Loop Horizontal Vertical b) Open Loop Surface Discharge Inj. of Water Other (specify):

Was a chemical/bacteriological sample submitted to KDHE? Yes No If yes, date sample was submitted: Water well disinfected? Yes No

8 TYPE OF CASING USED: Steel PVC Other CASING JOINTS: Glued Clamped Welded Threaded Casing diameter 2 in. to 6.79 ft, Diameter in. to ft, Diameter in. to ft, Casing height above land surface -0.41 in. Weight lbs./ft. Well thickness or gauge No TYPE OF SCREEN OR PERFORATION MATERIAL: Steel Stainless Steel Fiberglass PVC Brass Galvanized Steel Concrete tile None used (open hole) SCREEN OR PERFORATION OPENINGS ARE: Continuous Slot Mill Slot Gauze Wrapped Torch Cut Drilled Holes Other (Specify) Louvered Shutter Key Punched Wire Wrapped Saw Cut None (Open Hole) SCREEN-PERFORATED INTERVALS: From 6.79 ft. to 21.79 ft. From ft. to ft. From ft. to ft. GRAVEL PACK INTERVALS: From 5 ft. to 22.5 ft. From ft. to ft. From ft. to ft.

9 GROUT MATERIAL: Neat cement Cement grout Bentonite Other Concrete: 0-0.5ft Grout intervals: From 0.5 ft. to 5 ft. From ft. to ft. From ft. to ft.

Nearest source of possible contamination: Septic Tank Lateral Lines Pit Privy Livestock Pens Insecticide Storage Sewer Lines Cess Pool Sewage Lagoon Fuel Storage Abandoned Water Well Watertight Sewer Lines Seepage Pit Feedyard Fertilizer Storage Oil Well / Gas Well Other (Specify) Direction from well? W/SW Distance from well? ~255 ft ft

Table with 6 columns: 10 FROM, TO, LITHOLOGIC LOG, FROM, TO, LITHO. LOG (cont.) or PLUGGING INTERVALS. Rows: 0-0.3 Topsoil, 0.3-2 Silty clay with gravel, 2-22.5 Silty clay.

Notes: KDHE ID: Swiercinsky Brothers (former); U5-079-14713

11 CONTRACTOR'S OR LANDOWNER'S CERTIFICATION: This water well was constructed, reconstructed, or plugged under my jurisdiction and was completed on (mo-day-year) 1/25/16 and this record is true to the best of my knowledge and belief. Kansas Water Well Contractor's License No 757 This Water Well Record was completed on (mo-day-year) 2/25/16 under the business name of Larsen & Associates, Inc. Signature

Mail 1 white copy along with a fee of \$5.00 for each constructed well to: Kansas Department of Health and Environment, Bureau of Water, GWTS Section, 1000 SW Jackson St., Suite 420, Topeka, Kansas 66612-1367. Mail one to Water Well Owner and retain one for your records. Telephone 785-396-5824.

# DENNIS L HANDKE

1820 NW 59th Terrace  
TOPEKA, KANSAS 66618  
785-286-4047 Home  
785-286-1990 Fax

Jessica Chapman  
Larsen & Associates  
1311 E. 25<sup>th</sup> Street, Suite B  
Lawrence, Kansas, 66046

February 11, 2016

RE: Monitor Well Elevation Survey  
1511 M Street, Belleville, Kansas

Proj. 16-00B  
Swiercinsky Brothers (former)  
U5-079-14713

Bench Mark: Chisled Sq. on NE corner of storm inlet at NE corner of property.  
Elev: 1540.31      North 4830.74      West 4617.79      (from SE Cor. Sec. 2-3-3W)

MW-10	rim	1539.37	North	5025.45	NE1/4,NW1/4,NW1/4,NW1/4
	top pipe	1539.09	West	4684.42.	Lat= 39.82655    Long = 97.63113
MW-11	rim	1539.73	North	5025.16	NW1/4,NE1/4,NW1/4,NW1/4
	top pipe	1539.49	East	4511.05	Lat= 39.82655    Long = 97.63051
MW-12	rim	1538.98	North	5029.81	NW1/4,NE1/4,NW1/4,NW1/4
	top pipe	1538.71	West	4373.13	Lat= 39.82656    Long = 97.63002
MW-13	rim	1541.25	North	4856.30	SW1/4,NE1/4,NW1/4,NW1/4
	top pipe	1540.84	East	4376.85	Lat= 39.82609    Long = 97.63003

Lat & Long derived existing Belleville 7.5' quad map. WGS84

Elevation established from existing well project.

If you have any questions, please feel free to call me. Thank you for the opportunity to be of service.

